

# JACKSON MISSISSIPPI BOARD OF WATER COMMISSIONERS

~~0300~~

51

## WATER WELL DRILLERS LOG

5-25-60

Date: May 25, 1960, Driller: C. J. Switzer Well Co. County Jackson  
 59 (Name)

(1) Owner of Land: John P. Jucei  
Suter Family Camp Road  
Gautier, Miss.  
 (Address)

(2) Location: 1/4, 1/4, Sec. 36 T75R74  
North West Part of  
Gautier  
 miles \_\_\_\_\_, of \_\_\_\_\_  
 (distance) (direction) (Nearest Town)

(3) Topography: ✓  
 (Hilly) (Flat) (Level)

(4) Purpose of Well: Domestic  
 (Domestic Irrigation  
 Municipal, Industrial, Other)

Description & Color of Materials Sand, Clay, Red Clay, Shell, etc.	Thick- ness Feet	Depth Feet
<u>Clay</u>		<u>28</u>
<u>Sand</u>	<u>28</u>	<u>101</u>
<u>Clay</u>	<u>101</u>	<u>137</u>
<u>Stratified sand</u>	<u>137</u>	<u>168</u>
<u>Clay</u>	<u>168</u>	<u>202</u>
<u>fine sand</u>	<u>202</u>	<u>231</u>
<u>good sand</u>	<u>231</u>	<u>273</u>

Information upon completion of well:

(1) Diameter 2" inches.

(2) Total Depth 273 feet.

(3) Water Level 14' - \_\_\_\_\_ feet below top of ground.

(4) Cased to 273', Size 2"


(5) Screen: Size 10 #, Length 10'

(6) Were any formations sealed against pollution?  
✓ yes, \_\_\_\_\_ no.

If YES depth of formation 10 feet

Why Health dept. requirement

Drillers Remarks: \_\_\_\_\_

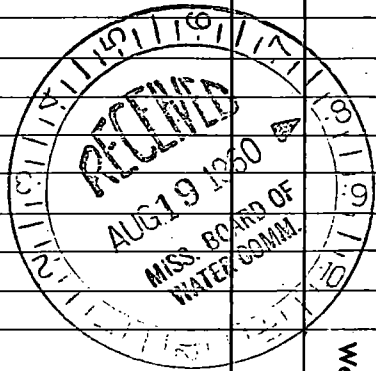

(Use Back Side)

Well No.

