

JACKSON MISSISSIPPI BOARD OF WATER COMMISSIONERS

~~052~~ 052
9-28-64

WATER WELL DRILLERS LOG

Date: 9-28, 1964, Driller: C. T. Surtz Well Co County Jackson
(Name)

(1) Owner of Land: Miss. Gulf Coast Junior College District
(Name)

Highway 90 + Martin Bluff Rd
(Address)

(2) Location: SW 1/4, NW 1/4, Sec. 36 T. 7 R. 2
(distance) (direction) (Nearest Town)

(3) Topography: _____ of _____
(Hilly) (Flat) (Level)

(4) Purpose of Well: Municipal
(Domestic Irrigation) (Municipal, Industrial, Other)

Information upon completion of well:

(1) Diameter 4x6 inches.

(2) Total Depth 870 feet.

(3) Water Level -2' feet below top of ground.
to 205' - 6"

(4) Cased to 870', Size 4"

(5) Screen: Size 4", Length 60' 10"


(6) Were any formations sealed against pollution?
X yes, _____ no.

If YES depth of formation _____

Why Health Dept Agreement

Drillers Remarks: _____

Description & Color of Materials Sand, Clay, Red Clay, Shell, etc.	Thick-ness Feet	Depth Feet
Clay	0	10
Sand	10	23
Clay + sand trifed	23	45
Sand	45	68
Clay	68	78
Sand	78	88
Clay	88	184
Sand	184	325
Clay	325	395
Sand streaks	395	407
Clay	407	417
Sand streaks	417	427
Clay	427	439
Trifed sand + clay	439	479
Sand streaks	479	501
Sand	501	509
Clay	509	523
Clay + shale	523	545
Clay	545	566
Sand streaks	566	588
Shale	588	609
Trifed sand + clay	609	631
Sand. fine	631	649
Shale + sand sibs	649	675
Clay	675	697
Sand streaks	697	718
Sand	718	733
Clay + shale	733	739
Sand, fine	739	759
Sand	759	870

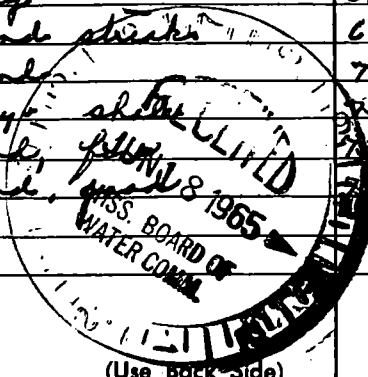

Well No.

(Use Back Side)

