

055

055

WATER WELL DRILLERS LOG

2-16-61


Date: 2/14, 1961, Driller: Colville Water Supply Co. County JACKSON
 49 (Name)

(1) Owner of Land: <u>H Massey</u> (Name)	Description & Color of Materials Sand, Clay, Red Clay, Shell, etc.	Thick- ness Feet	Depth Feet
<u>Singing River Gardens</u> (Address)			
(2) Location <u>NE 1/4 SE 1/4, Sec 12 T26R7W</u> <u>6</u> miles <u>North</u> , of <u>Bautie</u> (distance) (direction) (Nearest Town)			
(3) Topography: _____ (Hilly) (Flat) (Level) <input checked="" type="checkbox"/>	<u>depth form</u>		<u>depth form</u>
(4) Purpose of Well: _____ (Domestic Irrigation, Municipal, Industrial, Other)	<u>0 Clay 42 Sand</u> <u>84</u> <u>JP</u>		

Information upon completion of well:

- (1) Diameter 1 1/4 inches.
- (2) Total Depth 84 feet.
- (3) Water Level 14 feet below top of ground.
- (4) Cased to _____, Size _____
- (5) Screen: Size 1 1/4, Length 5'
- (6) Were any formations sealed against pollution?
 _____ yes, _____ no.

If YES depth of formation _____
 Why _____
 Drillers Remarks: _____

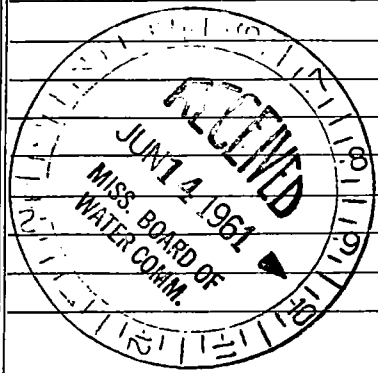

Well No. 032

(Use Back Side)

