

**JACKSON MISSISSIPPI BOARD OF WATER COMMISSIONERS**

061

9-28-61

**WATER WELL DRILLERS LOG**

Date: Sept 28, 1961, Driller: Colville County Jackson

49

(Name)

(1) Owner of Land: John Whitehead  
(Name)

Rawtiey  
(Address)

(2) Location: NE 1/4, SW 1/4, Sec. 36 T7SR7W

5 miles West of Pascagoula  
(distance) (direction) (Nearest Town)

(3) Topography: Flat  
(Hilly) (Flat) (Level)

(4) Purpose of Well: Service Station  
(Domestic Irrigation  
Municipal, Industrial, Other)

Description & Color of Materials  
Sand, Clay, Red Clay, Shell, etc.

Thick-  
ness  
Feet

Depth  
Feet

<u>YELLOW SAND</u>		<u>6</u>
<u>STRKS of Sand &amp; Clay</u>	<u>15</u>	<u>21</u>
<u>SAND</u>	<u>69</u>	<u>90</u>
<u>Clay</u>	<u>10</u>	<u>100</u>
<u>SAND</u>	<u>89</u>	<u>189</u>
<u>CLAY</u>	<u>10</u>	<u>199</u>
<u>SAND</u>	<u>95</u>	<u>294</u>
<u>Clay</u>	<u>26</u>	<u>320</u>
<u>SAND</u>	<u>28</u>	<u>328</u>
<u>Clay</u>	<u>50</u>	<u>378</u>
<u>HARD PACKED SAND</u>	<u>42</u>	<u>420</u>
<u>HARD CLAY</u>	<u>37</u>	<u>457</u>
<u>SAND</u>	<u>5</u>	<u>462</u>
<u>Clay</u>	<u>57</u>	<u>519</u>
<u>SAND</u>	<u>15</u>	<u>534</u>
<u>Clay</u>	<u>211</u>	<u>745</u>
<u>SANDSTONE</u>	<u>5</u>	<u>750</u>
<u>Clay</u>	<u>184</u>	<u>934</u>
<u>SAND</u>	<u>24</u>	<u>958</u>
		<u>TD</u>

Information upon completion of well:

(1) Diameter 2 inches.

(2) Total Depth 534 feet.

(3) Water Level 5' 4" feet below top of ground.

(4) Cased to \_\_\_\_\_, Size 2

(5) Screen: Size 2", Length 30'


(6) Were any formations sealed against pollution?  
\_\_\_\_\_ yes, \_\_\_\_\_ no.

If YES depth of formation \_\_\_\_\_

Why \_\_\_\_\_

Drillers Remarks: NON-productive

Stratum at 958

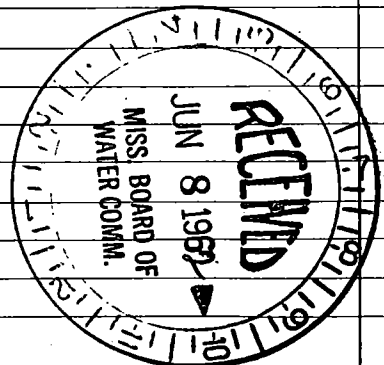

(Use Back Side)

Well No. 94

