

JACKSON MISSISSIPPI BOARD OF WATER COMMISSIONERS

666
5-3-62

WATER WELL DRILLERS LOG

Date May 3, 1962, Driller L. S. Garland County Jackson
(Name)

(1) Owner of Land	Description & Color of Materials Sand, Clay, Red Clay, Shell, etc.	Thick- ness Feet	Depth Feet
<u>Mc Elhenney</u> (Name) <u>New Highway</u> (Address)	1- 21' Clay		
(2) Location: $\frac{1}{4}$, $\frac{1}{4}$, Sec <u>25 T 7 S R 14 W</u> <u>3</u> miles <u>NW</u> , of <u>Hautier</u> (distance) (direction) (Nearest Town)	2- 21' Mixed		
(3) Topography: (Hilly) (Flat) (Level)	3- Sand		
(4) Purpose of Well: <u>Domestic</u> (Domestic Irrigation Municipal, Industrial, Other)	4- 14" 7' Mud		
	5- Mud		
	6- " 8' Sand		
	7- Mud		
	8- "		
	9- "		
	10- Sand		
	11- "		
	12- "		
	13- "		
	14- " 8' Sand 3' 8' Mud		
	15- 11' Mud 16' 7' Sand		
	16- Mixed		
	17- Mud		
	18- 7' Sand		
	19- Sand o.t.		
	20- Sand o.t.		

Information upon completion of well:

(1) Diameter 2 inches.

(2) Total Depth 420 feet.

(3) Water Level 5' feet below top of ground.

(4) Cased to _____, Size _____


(5) Screen: Size .08, Length 10'

(6) Were any formations sealed against pollution?
_____ yes, _____ no.

If YES depth of formation _____

Why _____

Drillers Remarks: _____

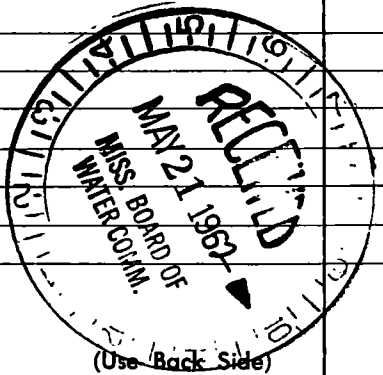

Well No. _____

