

68

WATER WELL DRILLERS LOG

5-18-62

Date: 7/18, 1962, Driller: Colville County JACKSON  
(Name)

(1) Owner of Land: <u>LW SNOW</u> <small>(Name)</small>	Description & Color of Materials Sand, Clay, Red Clay, Shell, etc.	Thick- ness Feet	Depth Feet
<u>Gautier</u> <small>(Address)</small>			
(2) Location: <u>NE 1/4, SW 1/4, Sec. 36 T25R7</u>  <small>miles (distance) of (direction) (Nearest Town)</small>	<u>Depth Form</u> <u>Depth Form</u> <u>0 CLAY 28 SAND</u> <u>39 CLAY 52 SAND</u> <u>68 70</u>		
(3) Topography: <u>✓</u> <small>(Hilly) (Flat) (Level)</small>			
(4) Purpose of Well: <u>Domestic</u> <small>(Domestic Irrigation Municipal, Industrial, Other)</small>			

Information upon completion of well:

(1) Diameter 1 1/4 inches.

(2) Total Depth 68 feet.

(3) Water Level 18 feet below top of ground.

(4) Cased to \_\_\_\_\_, Size \_\_\_\_\_


(5) Screen: Size 1 1/4, Length 5'

(6) Were any formations sealed against pollution?  
 \_\_\_\_\_ yes, \_\_\_\_\_ no.

If YES depth of formation \_\_\_\_\_

Why \_\_\_\_\_

Drillers Remarks: \_\_\_\_\_

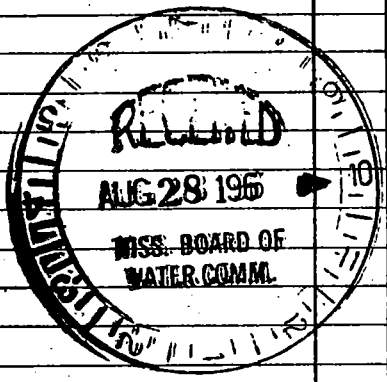

Well No. 127

(Use Back Side)

Handwritten notes on a grid background, including a large 'X' and various illegible text.