

JACKSON MISSISSIPPI BOARD OF WATER COMMISSIONERS

070

5-30-62

WATER WELL DRILLERS LOG

Date: 5-30, 1962, Driller: Colville County Jackson

49

(Name)

(1) Owner of Land: Floyd Fairley
(Name)

Gautier, Miss.
(Address)

(2) Location: SE 1/4, NW 1/4, Sec. 36 T. 2 R. 7 W

_____ miles _____ of _____
(distance) (direction) (Nearest Town)

(3) Topography: FLAT
(Hilly) (Flat) (Level)

(4) Purpose of Well: Domestic
(Domestic Irrigation
Municipal, Industrial, Other)

Description & Color of Materials
Sand, Clay, Red Clay, Shell, etc.

Thick-
ness
Feet

Depth
Feet

<u>Surface sand</u>	<u>2</u>	<u>2</u>
<u>yellow clay</u>	<u>19</u>	<u>21</u>
<u>blue clay</u>	<u>84</u>	<u>105</u>
<u>sand</u>	<u>26</u>	<u>131</u>


Information upon completion of well:

- (1) Diameter 1 1/4 inches.
- (2) Total Depth 131 feet.
- (3) Water level 12 feet below top of ground.
- (4) Cased to _____, Size _____.
- (5) Screen: Size 80 grs., Length 5.
- (6) Were any formations sealed against pollution?
_____ yes, no.

If YES depth of formation _____

Why _____

Drillers Remarks: _____

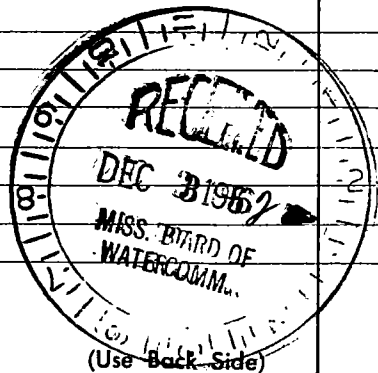

Well No. 136

