

MISSISSIPPI BOARD OF WATER COMMISSIONERS

JACKSON

071

6-2-62

WATER WELL DRILLERS LOG

Date: 6-2, 1962, Driller: George Colville County Jackson
 55 (Name)

(1) Owner of Land: <u>VERNON ROUSE</u> (Name)	Description & Color of Materials Sand, Clay, Red Clay, Shell, etc.	Thick- ness Feet	Depth Feet
<u>GAUTIER, Miss.</u> (Address)	<u>SANDY CLAY</u>	<u>10</u>	<u>10</u>
(2) Location: <u>Center of IRREGULAR</u> <u>1/4, 1/4, Sec. 13 T28R7W</u>	<u>Blue Clay</u>	<u>40</u>	<u>50</u>
<u>3</u> miles <u>South</u> of <u>GAUTIER</u> (distance) (direction) (Nearest Town)	<u>White Sand</u>	<u>18</u>	<u>68</u>
(3) Topography: <u>FLAT</u> (Hilly) (Flat) (Level)			
(4) Purpose of Well: <u>Domestic</u> (Domestic Irrigation Municipal, Industrial, Other)			


Information upon completion of well:

- (1) Diameter 1 1/4 inches.
- (2) Total Depth 68 feet.
- (3) Water level 11 feet below top of ground.
- (4) Cased to _____, Size _____.
- (5) Screen: Size 80 gr., Length 5.
- (6) Were any formations sealed against pollution?
 _____ yes, no.

If YES depth of formation _____.

Why _____.

Drillers Remarks: _____

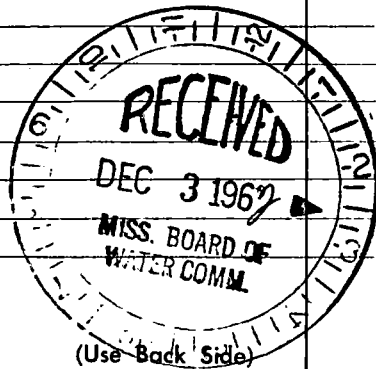

Well No. 138

