

JACKSON MISSISSIPPI BOARD OF WATER COMMISSIONERS

072

6-21-62

WATER WELL DRILLERS LOG

Date: 6-21, 1962, Driller: George Colville County Jackson

55


(Name)

	Description & Color of Materials Sand, Clay, Red Clay, Shell, etc.	Thick- ness Feet	Depth Feet
(1) Owner of Land: <u>Hal Vaughn</u>	<u>SOFT CLAY (Red)</u>	<u>53</u>	<u>53</u>
(Name) <u>Gautier, Miss</u>	<u>SAND</u>	<u>73</u>	<u>126</u>
(Address) <u>SE 1/4, SE 1/4, Sec. 3 T8S R7W</u>	<u>CLAY</u>	<u>21</u>	<u>147</u>
(2) Location: <u>SE 1/4, SE 1/4, Sec. 3 T8S R7W</u>	<u>SAND</u>	<u>20</u>	<u>167</u>
_____ miles _____ of _____	<u>CLAY</u>	<u>43</u>	<u>210</u>
(distance) _____ (direction) _____ (Nearest Town) _____	<u>SAND</u>	<u>110</u>	<u>320</u>
(3) Topography: <u>FLAT</u>	<u>CLAY</u>	<u>70</u>	<u>399</u>
(Hilly) _____ (Flat) _____ (Level) _____	<u>SAND</u>	<u>21</u>	<u>420</u>
(4) Purpose of Well: <u>Domestic</u>	<u>CLAY</u>	<u>31</u>	<u>451</u>
(Domestic Irrigation Municipal, Industrial, Other)	<u>SAND</u>	<u>9</u>	<u>460</u>
_____	<u>CLAY</u>	<u>17</u>	<u>483</u>
_____	<u>SAND</u>	<u>10</u>	<u>493</u>
_____	<u>CLAY</u>	<u>189</u>	<u>682</u>
_____	<u>SAND</u>	<u>73</u>	<u>755</u>

Information upon completion of well:

- (1) Diameter 2 inches.
- (2) Total Depth 755 feet.
- (3) Water Level 10 feet Above ~~below~~ top of ground.
- (4) Cased to _____, Size _____
- (5) Screen: Size No 8 slot, Length 10'
- (6) Were any formations sealed against pollution?
 yes, no.

If YES depth of formation _____
 Why _____
 Drillers Remarks: _____

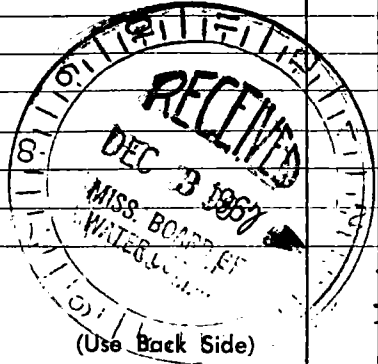

Well No. 171

