

# JACKSON MISSISSIPPI BOARD OF WATER COMMISSIONERS

74

8-20-62

## WATER WELL DRILLERS LOG

Date: Aug. 20, 1962, Driller: L. L. Garland County: Jackson  
 53 (Name)

(1) Owner of Land:	Description & Color of Materials Sand, Clay, Red Clay, Shell, etc.	Thick- ness Feet	Depth Feet
<u>James Grimsley</u> (Name)	1 Sand		
<u>Ocean Springs, Miss.</u> (Address)	2 19' Sand 4' Mud		
(2) Location: <u>1/4, 1/4, Sec. 11 T8R7</u>	3 18' Mud 3' Sand		
<u>10</u> miles <u>SE</u> of <u>O.S.</u> (distance) (direction) (Nearest Town)	4 Mixed		
(3) Topography: (Hilly) (Flat) (Level)	5 Mud & Sand Strbs.		
(4) Purpose of Well: <u>Domestic</u> (Domestic Irrigation, Municipal, Industrial, Other)	6 7' Sand 10' Mud 4' Sand		
	7 Mud		
	8 " & Sand Strbs.		
	9 Sand		
	10 Mud		
	11 "		
	12 " & Sand Strbs.		
	13 18' Mud Rock 3' Mud		
	14 11' " & 10' Sand		
	15 Shale & Mud		
	16 " "		
	17 18' Mud 3' Sand		
	18 19' " 2' Sand		
	19 17' " "		
	20 Mud & Shale		
	21 9' Mix. 12' Sand		
	22 10' " 11' Sand		
	23 Sand		
	24 18' Mix. 3' Shale		
	25 Shale & Mud		
	26 11' Mud 10' Sand		
	27 Sand		
	28 14' Mix 7' Mud		
	29 Mud & Sand Strbs		
	30 Sand		
	31 Sand		
	32 5' " 16' Mud		

Information upon completion of well:

(1) Diameter 2 inches.

(2) Total Depth 1395 feet.

(3) Water Level Flowed feet below top of ground.

(4) Cased to \_\_\_\_\_, Size \_\_\_\_\_.


(5) Screen: Size .08, Length 20.

(6) Were any formations sealed against pollution?  
 \_\_\_\_\_ yes, \_\_\_\_\_ no.

If YES depth of formations \_\_\_\_\_

Why \_\_\_\_\_

Drillers Remarks: \_\_\_\_\_

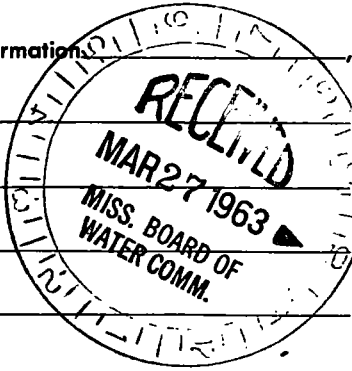

(Use Back Side)

Well No.

MISSISSIPPI BOARD OF WATER COMMISSIONERS


074

WATER WELL DRILLERS LOG

Date: \_\_\_\_\_, 19\_\_\_\_, Driller: \_\_\_\_\_ County Jackson

(Name)

	Description & Color of Materials Sand, Clay, Red Clay, Shell, etc.	Thick- ness Feet	Depth Feet
(1) Owner of Land: (Name)	33 & 34 Mud & Shale		
(Address)	35 & 36 " & Sand Strips		
(2) Location: _____ 1/4, _____ 1/4, Sec. _____ T. _____ R. _____	37 - Sand		
_____ miles _____ of _____	38 10' " 11' Mud		
(distance) _____ (direction) _____ (Nearest Town)	39 & 40 - Mixed		
(3) Topography: _____	41 Mud		
(Hilly) _____ (Flat) _____ (Level) _____	42 & 43 Mixed		
(4) Purpose of Well: _____	44, 45, 46, & 47 Mix.		
(Domestic Irrigation Municipal, Industrial, Other)	48 Shale		
Information upon completion of well:	49, 50, 51, 52 & 53 Mud		
(1) Diameter _____ inches.	54 15' Mud 6' Sand		
(2) Total Depth _____ feet.	55 " " "		
(3) Water Level _____ feet below top of ground.	56 Mixed		
(4) Cased to _____, Size _____	57-58 Sand		
(5) Screen: Size _____, Length _____	59 - 7' Rock 14' Mud		
(6) Were any formations sealed against pollution? _____ yes, _____ no.	60. Rock Strips		
If YES depth of formation _____	61 - Shale & Sand Strips		
Why _____	62, 63 & 64 Mixed		
Drillers Remarks: _____	65 - Sand		
	66 - "		
	67 - 9' Sand (Good)		

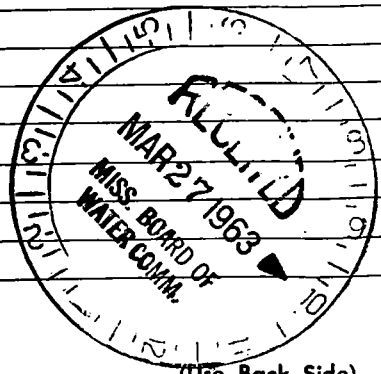

(Use Back Side)

Well No.