

JACKSON

75

WATER WELL DRILLERS LOG

Date: ~~8-25~~ ^{Aug-25-62} 25, 1962, Driller: John Colville County Jackson
 49 (Name)


(1) Owner of Land: H. C. Mardia
 (Name)
Gautier, Miss
 (Address)
 (2) Location: SE 1/4, NE 1/4, Sec. 36 T5R7E
3 miles West of Gautier
 (distance) (direction) (Nearest Town)
 (3) Topography: Flat
 (Hilly) (Flat) (Level)
 (4) Purpose of Well: Domestic
 (Domestic Irrigation
 Municipal, Industrial, Other)

Description & Color of Materials Sand, Clay, Red Clay, Shell, etc.	Thick- ness Feet	Depth Feet
0-10 clay		
10-21 slush		
21-42 clay		
42-63 sand		
63-70 sand		
70-84 clay		
84-105 clay		
105-120 sandy clay		
120-126 sandy clay		
126-147 clay		
147-168 clay		
168-189 clay		
189-210 gritty clay		
210-226 gritty clay		
226-231 sand		
231-246 sand		
TD		

Information upon completion of well:

(1) Diameter 1 1/4 inches.
 (2) Total Depth 246 feet.
 (3) Water Level 11' feet below top of ground.
 (4) Cased to _____, Size _____
 (5) Screen: Size 1 1/4, Length 10'
 (6) Were any formations sealed against pollution?
 _____ yes, X no.

If YES depth of formation _____
 Why _____
 Drillers Remarks: _____

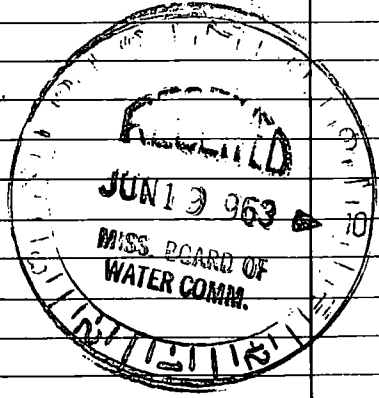

(Use Back Side)

Well No. 49

