

JACKSON MISSISSIPPI BOARD OF WATER COMMISSIONERS

78
10-30-62

WATER WELL DRILLERS LOG

Date: Oct. 30, 1962 Driller: L. L. Garland County Jackson
59 (Name)

(1) Owner of Land: Mr. Marsh
(Name)
Martin Bluff
(Address)

(2) Location: 1/4, 1/4, Sec. 12 T5 R7 W
3 miles N.E. of Fountain
(distance) (direction) (Nearest town)
bluff

(3) Topography: _____
(Hilly) (Flat) (Level)

(4) Purpose of Well: Dom.
(Domestic Irrigation
Municipal, Industrial, Other)

Description & Color of Materials Sand, Clay, Red Clay, Shell, etc.	Thick- ness Feet	Depth Feet
1 Clay		
2 Sand		
3 14' S. 7' Mud		
4 7' Mud 14' Sand		
5 Mix.		
6 Mud		
7 "		
8 Fine Sand		
9 Mix.		
10 16' " 5' Sand		
11 5' S. 16' Mud		
12 Mix.		
13 "		
14 11' Sand 10' Mud		
15 Mud		
16 Mix.		
17 "		
18 6' Mud 7' Rock 8' S.		
19 Shale		
20 14' Sand 7' Mud		
21 Mix.		
22 "		
23 Mud & Shale		
24 Mix.		
25 "		
26 12' Sand		

Information upon completion of well:

(1) Diameter 2 inches.

(2) Total Depth 537 feet
Flowed

(3) Water Level Flowed feet below top of ground.

(4) Cased to _____, Size _____


(5) Screen: Size .08, Length 10'

(6) Were any formations sealed against pollution?
_____ yes, _____ no.

If YES depth of formation _____

Why _____

Drillers Remarks: _____

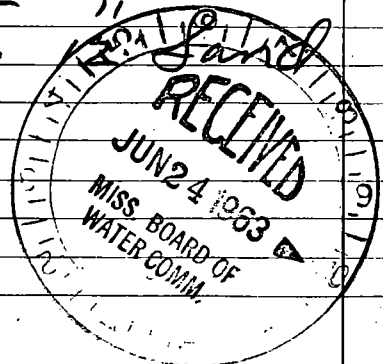

(Use Back Side)

Well No.

