

JACKSON

079

11-7-62

WATER WELL DRILLERS LOG

Date: Nov 7, 1962, Driller: George Cobille County Jackson  
(Name)

49

(1) Owner of Land:	Description & Color of Materials Sand, Clay, Red Clay, Shell, etc.	Thick- ness Feet	Depth Feet
<u>David Moffett</u> <small>(Name)</small> <u>Mantua</u> <small>(Address)</small> <u>Miss</u>	0-42 blue clay		
(2) Location: <u>SE 1/4, SE 1/4, Sec. 36 T15R7M</u> <u>1</u> miles <u>MW</u> , of <u>Mantua</u> <small>(distance) (direction) (Nearest Town)</small>	42-60 sand		
(3) Topography: <u>flat</u> <small>(Hilly) (Flat) (Level)</small>	60-63 sand streaks		
(4) Purpose of Well: <u>Domestic</u> <small>(Domestic Irrigation Municipal, Industrial, Other)</small>	84-99 clay		
	99-135 sand		
	135-210 clay		
	210-231 sand		
	TD		

Information upon completion of well:

(1) Diameter 1 1/4 inches.

(2) Total Depth 231 feet.

(3) Water Level 19'-5" feet below top of ground.

(4) Cased to \_\_\_\_\_, Size \_\_\_\_\_.


(5) Screen: Size 1 1/4, Length 10'

(6) Were any formations sealed against pollution?  
 \_\_\_\_\_ yes, X no.

If YES depth of formation \_\_\_\_\_

Why \_\_\_\_\_

Drillers Remarks: \_\_\_\_\_

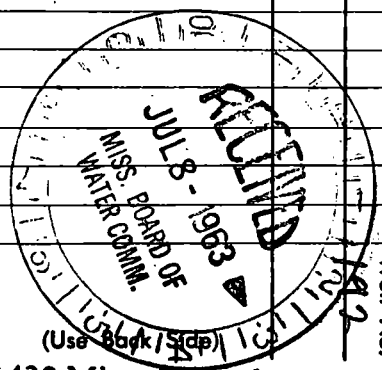

Well No. 1192

