

080

WATER WELL DRILLERS LOG

11-13-62

Date: Nov 13, 1962, Driller: George Calhoun County Jackson

(Name)

(1) Owner of Land: Mrs Carl Crews  
(Name)

Description & Color of Materials  
Sand, Clay, Red Clay, Shell, etc.

Thick-  
ness  
Feet

Depth  
Feet

0-21 sand

21-84 clay

84-90 sand

TD

Gautree Miss  
(Address)

(2) Location: Irregular lot 14 S 1/4, 1/4, Sec. T8R7

5 miles SW, of Gautree  
(distance) (direction) (Nearest Town)

(3) Topography: flat  
(Hilly) (Flat) (Level)

(4) Purpose of Well: domestic  
(Domestic Irrigation  
Municipal, Industrial, Other)

Information upon completion of well:

(1) Diameter 1 1/4 inches.

(2) Total Depth 90' feet.

(3) Water Level 14 feet below top of ground.

(4) Cased to \_\_\_\_\_, Size \_\_\_\_\_

(5) Screen: Size 1 1/4, Length 5'


(6) Were any formations sealed against pollution?

yes, X no.

If YES depth of formation \_\_\_\_\_

Why \_\_\_\_\_

Drillers Remarks: \_\_\_\_\_

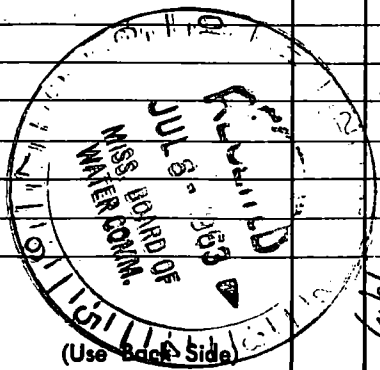

Well No. 1962

(Use back side)

