

0 82

5-18-63

WATER WELL DRILLERS LOG

Date: 5-18, 1963, Driller: Sutton Well Works County Jackson

53

(Name)

(1) Owner of Land: N. N. Briater

(Name)

741 Hilltop St. Jackson

(Address)

(2) Location: SW 1/4, SW 1/4, Sec. 12 T85R 74W

3 miles W of Gautier

(distance)

(direction)

(Nearest Town)

(3) Topography: flat

(Hilly)

(Flat)

(Level)

(4) Purpose of Well: domestic

(Domestic Irrigation, Municipal, Industrial, Other)

Description & Color of Materials Sand, Clay, Red Clay, Shell, etc.

Thick-ness Feet

Depth Feet

sand

15

15

clay

59

74

sand

36

110

Information upon completion of well:

(1) Diameter 2 inches.

(2) Total Depth 110 feet.

(3) Water level 10 feet below top of ground.

(4) Cased to ell, Size 2"

(5) Screen: Size 2", Length 5'


(6) Were any formations sealed against pollution?

yes, no.

If YES depth of formation

Why

Drillers Remarks:

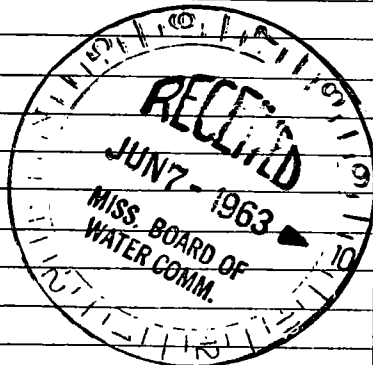

(Use Back Side)

Well No.

Handwritten text at the top of the page, possibly a header or title, which is mostly illegible due to the high level of noise and speckling.

Main body of handwritten text, appearing as several lines of cursive or semi-cursive script. The characters are heavily obscured by noise, making the specific words and numbers difficult to discern.

Continuation of the handwritten text, showing some faint outlines of what might be a list or a series of entries. Some characters, such as '10' and '11', are more clearly visible than others.

Bottom section of the page containing the final lines of handwritten text. The text is sparse and fragmented, with significant noise throughout.