


0 86  
12-11-64

WATER WELL DRILLERS LOG

Date: 12-11, 1964, Driller: Jay Latt County Jackson  
Superstone Gas Co. (Name)

4 5  
 (1) Owner of Land: Belle Fountain Church  
 (Name) Vanclaire  
 (Address)  
 (2) Location: NW 1/4, NE 1/4, Sec. 31 T2R7, S W  
 1 miles S of Belle Com.  
 (distance) (direction) (Nearest Town)  
 (3) Topography:  (Level)  
 (Hilly) (Flat)  
 (4) Purpose of Well: Domestic  
 (Domestic Irrigation, Municipal, Industrial, Other)

Description & Color of Materials Sand, Clay, Red Clay, Shell, etc.	Thick- ness Feet	Depth Feet
0-20-RS		
20-100-RC		
100-315-CC		
315-330-SS		

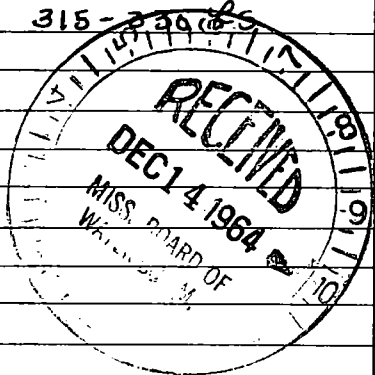

Information upon completion of well:

(1) Diameter 2 inches.  
 (2) Total Depth 330 feet.  
 (3) Water Level 6 feet below top of ground.  
 (4) Cased to \_\_\_\_\_, Size \_\_\_\_\_  
 (5) Screen: Size 2, Length 10 ft.  
 (6) Were any formations sealed against pollution?  
 \_\_\_\_\_ yes, \_\_\_\_\_ no.

If YES depth of formation \_\_\_\_\_

Why \_\_\_\_\_

Drillers Remarks: \_\_\_\_\_

(Use Back Side)

Well No.

