

JACKSON
089

MISSISSIPPI BOARD OF WATER COMMISSIONERS

7-66

WATER WELL DRILLERS LOG

Date: July 30, 1966, Driller: J. STORK (Colville) County JACKSON
45 (Name)

(1) Owner of Land: W. O. Spring
(Name)
Fontainebleau, Miss.
(Address)

(2) Location: NE 1/4, SE 1/4, Sec. 6 T8S R7W
12 miles W. of Pascagoula
(distance) (direction) (Nearest Town)

(3) Topography: FLAT
(Hilly) (Flat) (Level)

(4) Purpose of Well: Dom
(Domestic Irrigation
Municipal, Industrial, Other)

Description & Color of Materials Sand, Clay, Red Clay, Shell, etc.	Thick- ness Feet	Depth Feet
Sand	20	20
CLAY	35	55
Sand	15	70
SAND & CLAY STRKS	84	154
Sand	56	210
CLAY	5	215
Sand	5	220
CLAY	42	262
Rock	2	264
CLAY	40	304
Sand	11	315
CLAY	20	335
Sand	35	370

Information upon completion of well:

(1) Diameter 2 inches.

(2) Total Depth 370 feet.

(3) Water Level 12 feet below top of ground.

(4) Cased to 360, Size 2 in.


(5) Screen: Size .012, Length 10 ft.

(6) Were any formations sealed against pollution?
_____ yes, no.

If YES depth of formation _____

Why _____

Drillers Remarks: _____

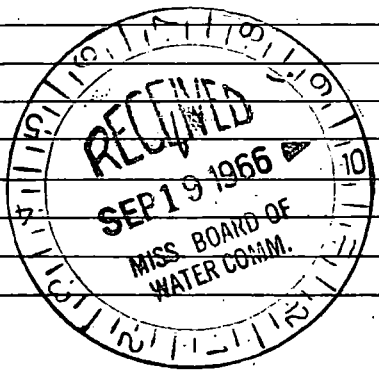

(Use Back Side)

Well No.

