

090  
8-66

WATER WELL DRILLERS LOG

Date: Aug 29, 1966, Driller: J. STORK (Bluffville) County Jackson  
45 (Name)

(1) Owner of Land: <u>DR. R. A. ROBERTS</u> (Name) <u>Fontainebleau Beach, Miss</u> (Address)	Description & Color of Materials <u>Sand</u> Sand, Clay, Red Clay, Shell, etc.	Thick-ness Feet <u>70</u>	Depth Feet <u>70</u>
(2) Location: <u>SW 1/4, SW 1/4, Sec. 19 T8S R7W</u> <u>15</u> miles <u>SW</u> , of <u>Pascagoula</u> (distance) (direction) (Nearest Town)			
(3) Topography: <u>FLAT</u> (Hilly) (Flat) (Level)			
(4) Purpose of Well: <u>DOM</u> (Domestic Irrigation Municipal, Industrial, Other)			

Information upon completion of well:

(1) Diameter 1 1/4 inches.

(2) Total Depth 70 feet.

(3) Water Level 10 feet below top of ground.

(4) Cased to 65, Size 1 1/4.


(5) Screen: Size 80ga., Length 5ft.

(6) Were any formations sealed against pollution?  
 yes,  no.

If YES depth of formation \_\_\_\_\_

Why \_\_\_\_\_

Drillers Remarks: \_\_\_\_\_

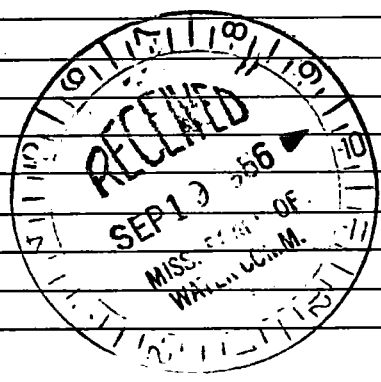

(Use Back Side)

Well No.

