

Jackson

D92

9-66

MISSISSIPPI BOARD OF WATER COMMISSIONERS

45

WATER WELL DRILLERS LOG

Date: 9-30, 1966, Driller C.T. Switzer Well Co. County Jackson

(When well drilled)

(Name)

(Where well is located)

(1) Owner of Land: Joe A. Cox (Name)

Belle Fountain Rd, - 1 1/2 W. Fountain Blue Road (Address)

(2) Location: 1/4, 1/4; Sec 31 75 7W NE NW (distance) (direction) (Nearest Town)

(3) Topography: X (Hilly) (Flat) (Level)

(4) Purpose of Well: Domestic (Domestic Irrigation Municipal, Industrial, Other)

Information upon completion of well:

(1) Diameter 2 inches.

(2) Total Depth 362 feet.

(3) Water Level 14 feet below top of ground.

(4) Cased to 362", Size 2"

(5) Screen: Size 80 SS, Length 10'

(6) Were any formations sealed against pollution? X yes, no.

YES depth of formation

Why Health Dept. Rejected.


Drillers Remarks:

Yield in gpm:

Size pump:

Type power:

Table with 3 columns: Description & Color of Materials, Thickness Feet, Depth Feet. Rows include clay, sand, mixed, soft clay, cldy, sand, clay, mixed, clay, sand, clay, fine sand, clay, rock, clay, sand.

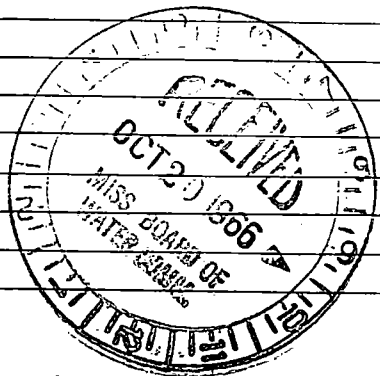

Ques
diss
100