

Jackson
 O 95
 2-67
 55

MISSISSIPPI
 BOARD OF WATER COMMISSIONERS
 416 North State Street
 Jackson, Mississippi 39201

WATER WELL DRILLERS LOG

2-15 1967 Switzer Well Co. Jackson
 date well completed firm name county well located


LANDOWNER: <u>C. H. Yocum</u>	description of formations encountered	from	to
<u>Draveline Rd. 1/2 mi. E. Ladno Rd. Intersection - Gautier</u> (mailing address)			
WELL LOCATION: sec. <u>12</u> T. <u>8</u> S. R. <u>7</u> E. W. (distance) miles of <u>GAUTIER</u> (direction) (nearest town) WELL PURPOSE: <u>Home</u> (home, irrigation, municipal, industrial) WELL COMPLETION DATA: (1) diameter (inches) <u>2</u> (2) total depth (feet) <u>273</u> (3) static water level (feet) <u>15</u> below top of ground. (4) casing <u>gal. steel</u> <u>263</u> , (material) (depth) <u>2"</u> if telescope see back. (size) (5) screen <u>4'</u> , <u>269'</u> (length) (depth to top) <u>6"</u> , <u>glass on pipe</u> (size) (material) (6) pump <u>1/2</u> <u>8</u> (HP) (yield gpm) <u>ELECTRIC</u> (type power) (7) electric log <u>No</u> (yes or no) (organization running log) (8) how well bottom plugged <u>Back Pressure Valve</u>	clay	0	10
	sand	10	14
	clay	14	22
	mixed	22	43
	sand	43	71
	clay	71	87
	coarse sand	87	120
	clay	120	140
	coarse sand	140	167
	sand	167	183
coarse sand	183	187	
sandy clay	187	203	
sand	203	208	
clay	208	245	
good sand	245	272	
sand	272	274	



If well telescopes please sketch and show depths.

GROUND LEVEL

5N 5E

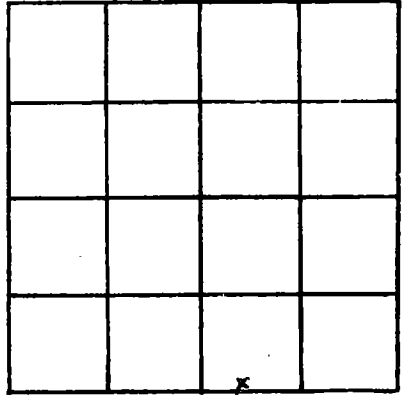

SECTION 1d

Please indicate well location X.

ADDITIONAL INFORMATION

If more than one screen, show locations of each on sketch.