

Ridgell

MISSISSIPPI
BOARD OF WATER COMMISSIONERS
416 North State Street
Jackson, Mississippi 39201

WATER WELL DRILLERS LOG

Jackson
D 96
1-67
49

1-7 1967 Coast Water Well Serv Jackson
 date well completed firm name county well located


LANDOWNER: J. D. Adams
Granite, Miss
Star Route
 (mailing address)

description of formations encountered	from	to
Ref Clay	0	10
Sand - fine	10	21
Blue Clay	21	63
Sand - coarse	63	84
Blue Clay	84	126
Sand fine - med	126	168
Sand med - coarse	168	252
Sand med - fine	252	273
Blue Clay	273	315
Blue Clay	315	420
Sandy shale	420	431
Blue Clay	431	452
Sand med - coarse	452	462
Blue Clay	462	473
Sand med - coarse	473	504

WELL LOCATION:
 sec. 26 T 7 S R. 7 E
6 miles West of Pascagoula
 (distance) (direction) (nearest town)

WELL PURPOSE: Domestic
 (home, irrigation, municipal, industrial)

- WELL COMPLETION DATA:
- (1) diameter (inches) 2
 - (2) total depth (feet) 504
 - (3) static water level (feet) 6 below top of ground.
 - (4) casing (material) (depth) (size) if telescope see back.
 - (5) screen 10' 484 (length) (depth to top) 2" Stainless (size) (material)
 - (6) pump 1/3 550-600 (HP) (yield gpm) Elect. 110 (type power)
 - (7) electric log NO (yes or no) (organization running log)
 - (8) how well bottom plugged Drop Pin

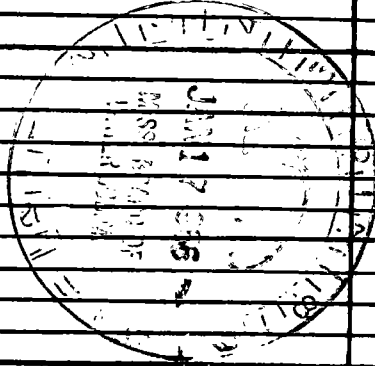

DRILLERS REMARKS: This well was drilled one one way trip with string attached & 10' tail pipe.

