

45

JACKSON
097
4-67

MISSISSIPPI
 BOARD OF WATER COMMISSIONERS
 416 North State Street
 Jackson, Mississippi 39201

WATER WELL DRILLERS LOG

4-13 1967 HATTIESBURG Butane JACKSON
 date well completed firm name county well located

LANDOWNER: De Clint Smith

Rt. 3

Ocean Springs, Miss.
(mailing address)

WELL LOCATION:

sec. 20 T 7 S R 7 E
 5 miles EAST of Ocean Springs
 (distance) (direction) (nearest town)

WELL PURPOSE: Home
(home, irrigation, municipal, industrial)


WELL COMPLETION DATA:

- (1) diameter (inches) 2"
- (2) total depth (feet) 263'
- (3) static water level (feet) 25' below top of ground.
- (4) casing Galv. pipe 253' (material) (depth)
2" (size) if telescope see back.
- (5) screen 10' (length) 253' (depth to top)
2" (size) BRONZE (material)
- (6) pump 1 (HP) 325 (yield gpm)
electric (type power)
- (7) electric log NO (yes or no)
NO (organization running log)
- (8) how well bottom plugged BACK WASH VALVE

description of formations encountered

from to

Red clay	0	10
sand + blue clay	10	30
white sand	30	118
Blue clay	118	130
white sand + blue clay	130	140
Blue clay	140	165
white sand	165	180
sand + clay	180	190
white sand	190	210
Salt + pepper sand	210	263

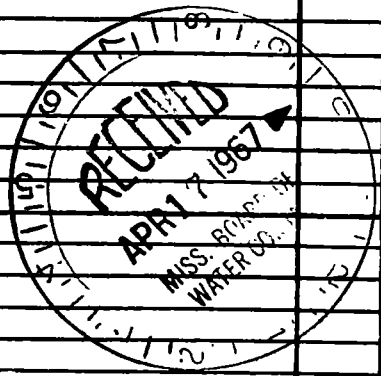


DRILLERS REMARKS:

If well telescopes please sketch and show depths.

GROUND LEVEL

SE NW

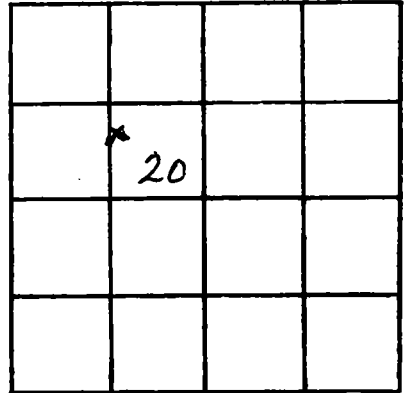

SECTION 20

Please indicate well location X.

ADDITIONAL INFORMATION

If more than one screen, show locations of each on sketch.