

55

Jackson  
099  
4-67

MISSISSIPPI  
BOARD OF WATER COMMISSIONERS  
416 North State Street  
Jackson, Mississippi 39201

WATER WELL DRILLERS LOG

4-20 1967 Coast Water Well Driller Jackson  
date well completed firm name county well located

LANDOWNER: H. Nelson

description of formations  
encountered

from to

Paragould, Miss.

Red Sandy Clay 0 15  
Blue Clay 15 30  
Hard red base 30 89

(mailing address)

base of the sand  
noted last had  
a seal above  
color (the top  
30 feet)

WELL LOCATION:

sec. 19 T-8 N R-7 E  
10 miles SE of Paragould  
(distance) (direction) (nearest town)

WELL PURPOSE: Crop  
(home, irrigation, municipal, industrial)


WELL COMPLETION DATA:

- (1) diameter (inches) 2
- (2) total depth (feet) 89
- (3) static water level (feet) 10 below top of ground
- (4) casing Galv. 84 (material) (depth)  
2" (size) If telescope see back.
- (5) screen 5' 84 (length) (depth to top)  
2" (size) Stainless Wiggins (material)
- (6) pump 1/2 (HP) 750 (yield gpm)  
Elect (type power)
- (7) electric log NO (yes or no)

(organization running log)

(8) how well bottom plugged  
Back wash Valve


DRILLERS REMARKS:

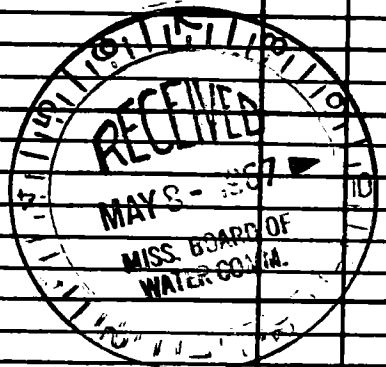

If well telescopes please sketch and show depths.

NW SE

GROUND LEVEL

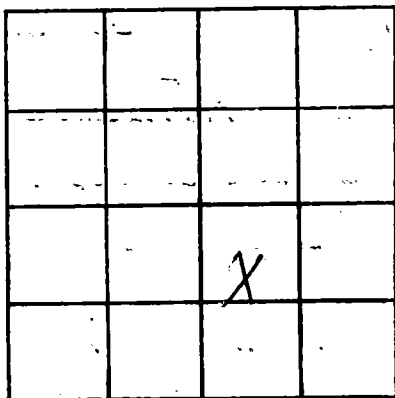

SECTION 19

Please indicate well location X.

ADDITIONAL INFORMATION

If more than one screen, show locations of each on sketch.