

55

Jackson

0100

4-67

MISSISSIPPI
 BOARD OF WATER COMMISSIONERS
 416 North State Street
 Jackson, Mississippi 39201

WATER WELL DRILLERS LOG

4-8 1967 Eastwater well in Jackson
 date well completed firm name county well located

LANDOWNER: Fred Taylor
Gautier, Miss

description of formations encountered	from	to
<u>Red Clay</u>	<u>0</u>	<u>7</u>
<u>Sand - fine</u>	<u>7</u>	<u>21</u>
<u>Blue Clay</u>	<u>21</u>	<u>42</u>
<u>Sand fine med</u>	<u>42</u>	<u>68</u>

(mailing address)

WELL LOCATION:
 sec 12 T 8 N R 2 E
3 miles SW of Gautier
 (distance) (direction) (nearest town)

WELL PURPOSE: Home
 (home, irrigation, municipal, industrial)


WELL COMPLETION DATA:

- (1) diameter (inches) 1 1/4"
- (2) total depth (feet) 68
- (3) static water level (feet) 12 below above top of ground.
- (4) casing Galv 63
 (material) (depth)
1 1/2"
 (size) if telescope see back.
- (5) screen 5 ft 63
 (length) (depth to top)
1 1/4" Brass
 (size) (material)
- (6) pump 1/2 600
 (HP) (yield gpm)
Elect
 (type power)
- (7) electric log NO
 (yes or no)

(organization running log)

(8) how well bottom plugged Back Wash Valve

DRILLERS REMARKS:

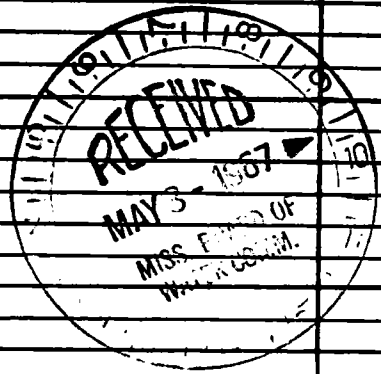

If well telescopes please sketch and show depths.

SESW

GROUND LEVEL

	X		

SECTION 12

Please indicate well location X.

ADDITIONAL INFORMATION

If more than one screen, show locations of each on sketch.