

49

Jackson
0102
5-67

MISSISSIPPI
 BOARD OF WATER COMMISSIONERS
 416 North State Street
 Jackson, Mississippi 39201

WATER WELL DRILLERS LOG

5-6 date well completed 1967 Coast Water Well Service firm name Jackson county well located

LANDOWNER: George Kent
 Star Route ~~Star Route~~
 Gautier Miss.
 (mailing address)

description of formations encountered	from	to
Red Clay	0	30
Blue Clay	30	69
Sand and coarse	69	89


WELL LOCATION:
 sec. 12 T 7 N R 7 E
 S W
 6 miles NORTH of GAUTIER
 (distance) (direction) (nearest town)

WELL PURPOSE: Home
 (home, irrigation, municipal, industrial)

WELL COMPLETION DATA:

(1) diameter (inches) 1 1/4"
 (2) total depth (feet) 89
 (3) static water level (feet) 11 below top of ground
 (4) casing 1 1/4" (material) 84' (depth)
 1 1/4" (size) if telescope see back.
 (5) screen 5' (length) 84' (depth to top)
 1 1/4" (size) Brass (material)
 (6) pump 1/2 (HP) 400 (yield gpm)
 (type power)
 (7) electric log NO (yes or no)
 (organization running log)
 (8) how well bottom plugged Backwash valve

DRILLERS REMARKS:

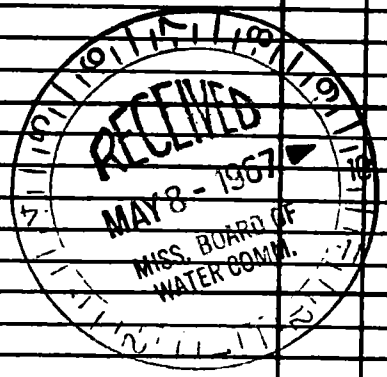

If well telescopes please sketch and show depths.

NE SW

GROUND LEVEL

	X		

SECTION 12

Please indicate well location X.

ADDITIONAL INFORMATION

If more than one screen, show locations of each on sketch.