

49

JACKSON
0104
8-67

MISSISSIPPI
 BOARD OF WATER COMMISSIONERS
 416 North State Street
 Jackson, Mississippi 39201

WATER WELL DRILLERS LOG

Aug 10 1967 Coastwaterwell Jackson
 date well completed firm name county well located


LANDOWNER: Zepherwaltman
Rt. 3 Box 246
Ocean Springs Miss.
 (mailing address)

description of formations encountered	from to	
	feet	feet
<u>clay</u>	<u>0</u>	<u>30</u>
<u>sand</u>	<u>30</u>	<u>45</u>
<u>yellow mud</u>	<u>45</u>	<u>60</u>
<u>Med. sand</u>	<u>60</u>	<u>94</u>

WELL LOCATION:
 sec. 17 T 7 N R 7 E
10 miles South of Unilow
 (distance) (direction) (nearest town)

WELL PURPOSE: home
 (home, irrigation, municipal, industrial)

- WELL COMPLETION DATA:
- (1) diameter (inches) 2
 - (2) total depth (feet) 94
 - (3) static water level (feet) 16 below top of ground
 - (4) casing galv. 89
 (material) (depth)
 If telescope see back.
 (size)
 - (5) screen 5' 89
 (length) (depth to top)
2" stainless
 (size) (material)
 - (6) pump 1/2 500/108
 (HP) (yield gpm)
elect.
 (type power)
 - (7) electric log no
 (yes or no)
 (organization running log)
 - (8) how well bottom plugged each was used

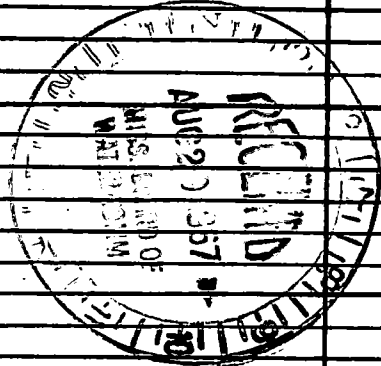

DRILLERS REMARKS:

If well telescopes please sketch and show depths.

GROUND LEVEL

SE NE

			X

SECTION 17

Please indicate well location X.

ADDITIONAL INFORMATION:

If more than one screen, show locations of each on sketch.