

MISSISSIPPI
BOARD OF WATER COMMISSIONERS
416 North State Street
Jackson, Mississippi 39201

WATER WELL DRILLERS LOG

45
Jackson
0105
11-67

11-9-67 date well completed 19 COAST WATER WELL SERVICE firm name JACKSON county well located

LANDOWNER: J.S. GIBSON
GAUTIER

description of formations encountered from to

RED CLAY 0 8
MED SAND 8 14
BLUE CLAY 19 69
MED SAND 69 89

(mailing address)

WELL LOCATION:

sec. 14 T. 8 N R. 7 E
6 miles West of Raymond
(distance) (direction) (nearest town)

WELL PURPOSE: Home
(home, irrigation, municipal, industrial)


WELL COMPLETION DATA:

- (1) diameter (inches) 2"
- (2) total depth (feet) 89
- (3) static water level (feet) 14' below top of ground
- (4) casing GAW 84'
(material) (depth)
- 2" If telescope see back.
(size)
- (5) screen 5" 84'
(length) (depth to top)
- 2" PLASTIC
(size) (material)
- (6) pump 1/2 8
(HP) (yield gpm)
- Elect
(type power)
- (7) electric log NO
(yes or no)

(organization running log)

(8) how well bottom plugged 2" BACK
WASH VALVE

DRILLERS REMARKS:

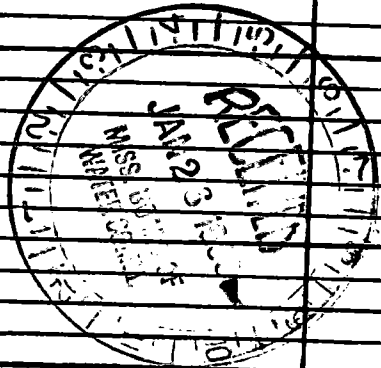

If well telescopes please sketch and show depths.

GROUND LEVEL

SW SE

		X	

SECTION M

Please indicate well location X.

ADDITIONAL INFORMATION

If more than one screen, show locations of each on sketch.