

5.5

Jackson  
0106  
11-67

MISSISSIPPI  
BOARD OF WATER COMMISSIONERS  
416 North State Street  
Jackson, Mississippi 39201

2

WATER WELL DRILLERS LOG

11-8-67 date well completed  
11-8-67 firm name  
COAST WATER WELL SERVICE JACKSON county well located

LANDOWNER: PHILIP RICHARD GAUTIER, Miss.

description of formations encountered from to

RED CLAY 0 6  
COARSE SAND 6 14  
BLUE CLAY 14 47  
MED SAND 47 68

(mailing address)

WELL LOCATION:

sec 12 T 8 N R 7 E S W  
6 miles West of Bogalusa  
(distance) (direction) (nearest town)

WELL PURPOSE: Hand  
(home, irrigation, municipal, industrial)


WELL COMPLETION DATA:

- (1) diameter (inches) 2"
- (2) total depth (feet) 68'
- (3) static water level (feet) 14' below top of ground.
- (4) casing GALV. 63'  
(material) (depth)  
2" if telescope see back.  
(size)
- (5) screen 5' 63'  
(length) (depth to top)  
2" PLASTIC  
(size) (material)
- (6) pump 1/2 8  
(HP) (yield gpm)  
Elect.  
(type power)
- (7) electric log NO  
(yes or no)

(organization running log)

(8) how well bottom plugged 2" BACK WASH VALVE

DRILLERS REMARKS:

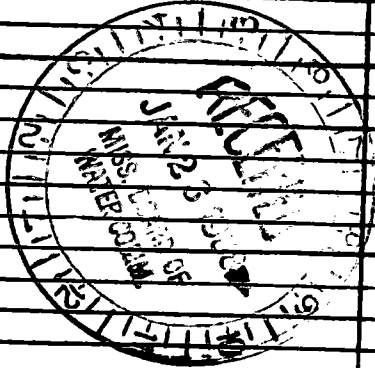

If well telescopes please sketch and show depths.

GROUND LEVEL

NWSE

		X	

SECTION 12

Please indicate well location X.

ADDITIONAL INFORMATION

If more than one screen;  
show locations of each on sketch.