

MS Commission 29116 a
 Date: 57.

JACKSON
0 110
4-68

MISSISSIPPI
 BOARD OF WATER COMMISSIONERS
 416 North State Street
 Jackson, Mississippi 39201

WATER WELL DRILLERS LOG

April 24, 1968 Switzer Well Co. Jackson
 date well completed firm name county well located

LANDOWNER: C. L. Holada Sr.

description of formations encountered	depth	
	from	to
<u>Mixed</u>	<u>0</u>	<u>22</u>
<u>Fine sand</u>	<u>22</u>	<u>42</u>
<u>Mixed sand</u>	<u>42</u>	<u>83</u>
<u>Clay</u>	<u>83</u>	<u>93</u>
<u>Mixed</u>	<u>93</u>	<u>103</u>
<u>Fine sand</u>	<u>103</u>	<u>122</u>
<u>Fair sand</u>	<u>122</u>	<u>143</u>
<u>Good sand</u>	<u>143</u>	<u>177</u>

Route 1, Box 56
Ocean Springs, Miss.
 (mailing address)

WELL LOCATION:
 sec 6 T 7 R 7
S W
5 1/2 miles S of VAN CLEVE
 (distance) (direction) (nearest town)

WELL PURPOSE: Home
 (home, irrigation, municipal, industrial)


WELL COMPLETION DATA:

- (1) diameter (inches) 2
- (2) total depth (feet) 177
- (3) static water level (feet) 8'5" below above top of ground.
- (4) casing gal steel, 167'
 (material) (depth)
2" if telescope see back.
 (size)
- (5) screen 10', 167'
 (length) (depth to top)
8 ga, SS on pipe
 (size) (material)
- (6) pump not installed
 (HP) (yield gpm)
 (type power)
- (7) electric log No
 (yes or no)
 (organization running log)
- (8) how well bottom plugged Back
pressure valve

DRILLERS REMARKS:

If well telescopes please sketch and show depths.

GROUND LEVEL

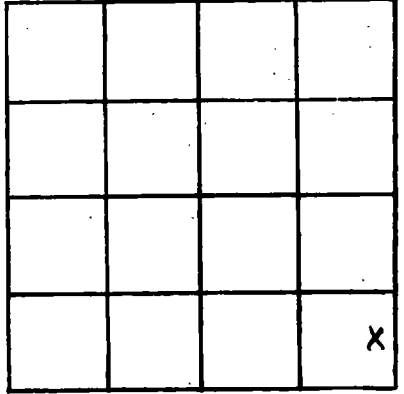

			X

SECTION 6

Please indicate well location X.

ADDITIONAL INFORMATION

If more than one screen,
show locations of each on sketch.