

JACKSON
0113
4-68

MISSISSIPPI
BOARD OF WATER COMMISSIONERS
416 North State Street
Jackson, Mississippi 39201

WATER WELL DRILLERS LOG

4-29-68 19 COAST WATER WELL SER. JACKSON
date well completed firm name county well located

LANDOWNER: ANDREW H. MAYERBACH

description of formations encountered

from to

General Del
Hunter, Miss.
(mailing address)

description of formations encountered	from	to
<u>LOAMY SOIL + LIGHT GRAY CLAY</u>	<u>0</u>	<u>16</u>
<u>FINE SAND</u>	<u>17</u>	<u>28</u>
<u>BLUE CLAY</u>	<u>28</u>	<u>79</u>
<u>MED. GRAIN SAND</u>	<u>79</u>	<u>90</u>

WELL LOCATION:

sec. 12 ^T 7 ^N R. 7 ^E
6 miles ^S North of ^W Hunter
(distance) (direction) (nearest town)

WELL PURPOSE: Home
(home, irrigation, municipal, industrial)

WELL COMPLETION DATA:

- (1) diameter (inches) 2"
- (2) total depth (feet) 90'
- (3) static water level (feet) 16' ^{below} ^{above} top of ground.
- (4) casing Galv., 85'
(material), (depth)
2" if telescope see back.
(size)
- (5) screen 5', 85'
(length), (depth to top)
2" PLASTIC
(size), (material)
- (6) pump 1/2 8
(HP) (yield gpm)
Electric
(type power)
- (7) electric log No
(yes or no)

(organization running log)

- (8) how well bottom plugged 2" BACK
WASH VALVE


DRILLERS REMARKS:

MAY 17 1968

MISS. BD. OF
WATER COMM.

If well telescopes please sketch and show depths.

GROUND LEVEL

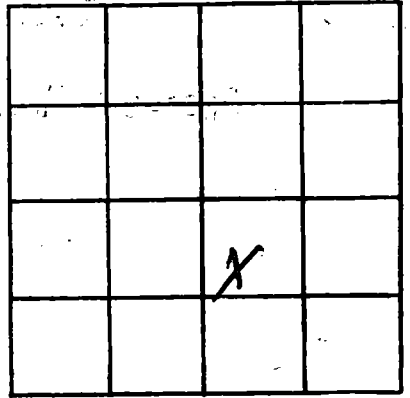

SECTION 12

Please indicate well location X.

ADDITIONAL INFORMATION

If more than one screen, show locations of each on sketch.