

JACKSON  
0119  
4-68

MISSISSIPPI  
BOARD OF WATER COMMISSIONERS  
416 North State Street  
Jackson, Mississippi 39201

WATER WELL DRILLERS LOG

April 12 1968 L.L. Garland water well Jackson  
date well completed firm name county well located

LANDOWNER: Phillip Davis  
Rt. 3

description of formations encountered from to

Ocean Springs, Miss  
(mailing address)

WELL LOCATION:

sec 30 T 7 N R 7 E W  
5 miles East of Ocean Springs  
(distance) (direction) (nearest town)

WELL PURPOSE: Home  
(home, irrigation, municipal, industrial)

WELL COMPLETION DATA:


- (1) diameter (inches) 2
- (2) total depth (feet) 504
- (3) static water level (feet) 14 below above top of ground.
- (4) casing (material) (depth) (size) if telescope see back.
- (5) screen 16 ft (length) (depth to top) 2" (size) brass (material)
- (6) pump 1/2 (HP) (yield gpm) electric (type power)
- (7) electric log no (yes or no) (organization running log)
- (8) how well bottom plugged with

DRILLERS REMARKS: 42 ft sand

JUN - 4 1968  
MISS. BOARD OF  
WATER COMM.

If well telescopes please sketch and show depths.

GROUND LEVEL

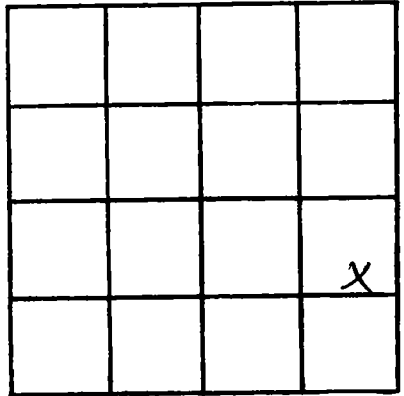

SECTION 30

Please indicate well location X.

ADDITIONAL INFORMATION

If more than one screen, show locations of each on sketch.