

JACKSON
 O 121
 6-64

MISSISSIPPI
 BOARD OF WATER COMMISSIONERS
 416 North State Street
 Jackson, Mississippi 39201

WATER WELL DRILLERS LOG

June 13 1964 Cabille Water Supply Jackson
 date well completed firm name county well located

LANDOWNER: Harold Krebs
Denton Miss
 (mailing address)

description of formations encountered	from	to
clay	0	5
sand	5	21
clay	21	22
sand	22	99

WELL LOCATION:
 sec. 12 T. 8 N. R. 7 E.
 (S) (W)
6 miles West of Pass
 (distance) (direction) (nearest town)

WELL PURPOSE: Irrigation
 (home, irrigation, municipal, industrial)


- WELL COMPLETION DATA:
- (1) diameter (inches) 3
 - (2) total depth (feet) 99
 - (3) static water level (feet) 16 ^{below} ~~above~~ top of ground
 - (4) casing Steel, 94
 (material) (depth)
 - 3 If telescope see back.
 (size)
 - (5) screen 5, 94
 (length) (depth to top)
 - 2", Stuuber
 (size) (material)
 - (6) pump _____ (HP) _____ (yield gpm)
 (type power)
 - (7) electric log no
 (yes or no)
 - _____ (organization running log)
 - (8) how well bottom plugged BP/Koby

MAY 27 1968
 MISS. BOARD OF
 WATER

DRILLERS REMARKS: Casing reduced to 2" screen pump installed by owner

If well telescopes please sketch and show depths.

GROUND LEVEL

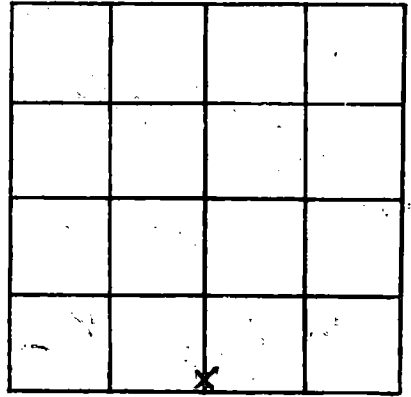

SECTION 12

Please indicate well location X.

ADDITIONAL INFORMATION

If more than one screen, show locations of each on sketch.