

Jackson  
0126  
9-9-68  
U.S.G.S.

MISSISSIPPI  
 BOARD OF WATER COMMISSIONERS  
 416 North State Street  
 Jackson, Mississippi 39201

CODED

WATER WELL DRILLERS LOG

date well completed 9-9-1968 Sutter Well Washer firm name Jackson county well located

LANDOWNER: Garner Lester  
Isadore Utilities  
Jackson Miss.  
 (mailing address)

description of formations encountered	depth	
	from	to
<u>sand</u>	<u>0</u>	<u>12</u>
<u>clay</u>	<u>12</u>	<u>37</u>
<u>sand</u>	<u>37</u>	<u>119</u>
<u>clay</u>	<u>119</u>	<u>129</u>
<u>sand</u>	<u>129</u>	<u>310</u>
<u>clay</u>	<u>310</u>	<u>500</u>
<u>sand</u>	<u>500</u>	<u>560</u>
<u>clay</u>	<u>560</u>	<u>700</u>
<u>sand</u>	<u>700</u>	<u>772</u>

WELL LOCATION:  
 sec. 35 T. 7 N. R. 7 E OK gr  
 (distance) miles \_\_\_\_\_ of Chaumont (nearest town)


WELL PURPOSE: Sub-division  
 (home, irrigation, municipal, industrial)

WELL COMPLETION DATA:

- (1) diameter (inches) 6 x 4
- (2) total depth (feet) 772
- (3) static water level (feet) 18 below top of ground.
- (4) casing Beh. steel 732'  
 (material) (depth)  
6x4 (size) if telescope see back.
- (5) screen 40' 732'  
 (length) (depth to top)  
4" Stainless Steel  
 (size) (material)
- (6) pump 10 150  
 (HP) (yield gpm)  
elec  
 (type power)
- (7) electric log yes  
 (yes or no)  
U.S.G.S.  
 (organization running log)

(8) how well bottom plugged BP/elec

DRILLERS REMARKS:

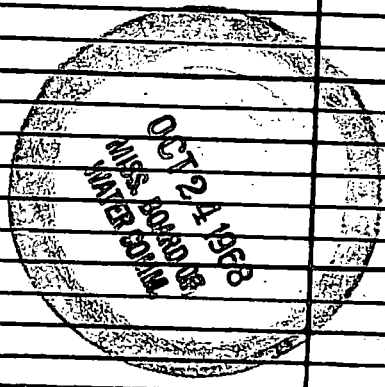

If well telescopes please sketch and show depths.

GROUND LEVEL

100' of 6" tel.

632' of 4" tel.

40' of 4" screen

			X

SECTION \_\_\_\_\_

Please indicate well location X.

ADDITIONAL INFORMATION

If more than one screen,  
show locations of each on sketch.