

Jackson  
 O 127  
 7-15-65

MISSISSIPPI  
 BOARD OF WATER COMMISSIONERS  
 416 North State Street  
 Jackson, Mississippi 39201

CODED

WATER WELL DRILLERS LOG

July 13 1965 Cahill's Water Supply Jackson  
 date well completed firm name county well located

LANDOWNER: Arthur S. Sunday  
 Gautier  
 (mailing address)

description of formations encountered	from	to
Clay	0	44
sand	44	63

WELL LOCATION:  
 sec. 33 T 7 N R 7 E  
 8 miles West of Pass  
 (distance) (direction) (nearest town)

WELL PURPOSE: Home  
 (home, irrigation, municipal, industrial)

WELL COMPLETION DATA:

(1) diameter (inches) 2x1 1/4

(2) total depth (feet) 63

(3) static water level (feet) 6 1/2' below top of ground.


(4) casing Galv. (material) (depth) (size) If telescope see back.

(5) screen 5' 58' (length) (depth to top)  
 1/4" Copper gauze (size) (material)

(6) pump (HP) (yield gpm) (type power)

(7) electric log no (yes or no) (organization running log)


(8) how well bottom plugged BP Valve

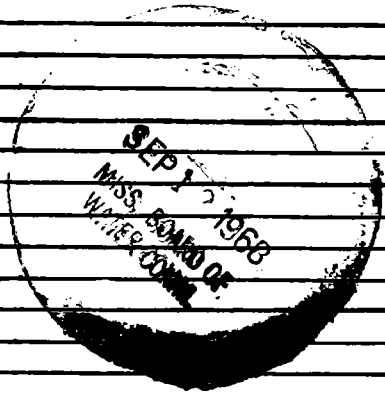

DRILLERS REMARKS: Pump installed by owner

If well telescopes please sketch and show depths.

GROUND LEVEL

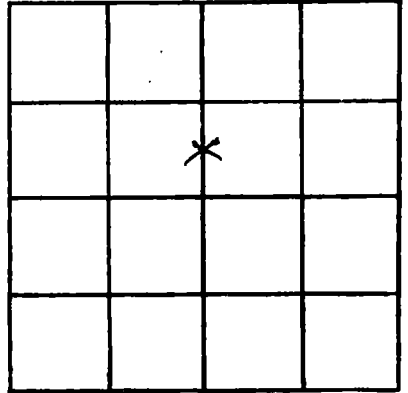

SECTION 33

Please indicate well location X.

ADDITIONAL INFORMATION

If more than one screen,  
show locations of each on sketch.