

Jackson  
 O 128  
 9-25-65

MISSISSIPPI  
 BOARD OF WATER COMMISSIONERS  
 416 North State Street  
 Jackson, Mississippi 39201

CODED

WATER WELL DRILLERS LOG

Sept 25 1965 Colville Water Sup Jackson  
 date well completed firm name county well located

LANDOWNER: W.P. Hall  
 Gauthier Miss  
 (mailing address)


description of formations encountered	from	to
clay	0	66
sand	66	78
clay	78	110
sand	110	120
clay	120	288
sand	288	300

WELL LOCATION:  
 sec 24 T 7 N R 7 E  
 8 miles West of Park  
 (distance) (direction) (nearest town)

WELL PURPOSE: home  
 (home, irrigation, municipal, industrial)

WELL COMPLETION DATA:


- (1) diameter (inches) 2
- (2) total depth (feet) 300
- (3) static water level (feet) 19 <sup>below</sup> top of ground
- (4) casing Galv. (material) (depth) \_\_\_\_\_  
 (size) If telescope see back.
- (5) screen 4 (length) 296 (depth to top)  
 2" (size) Stainless (material)
- (6) pump \_\_\_\_\_ (HP) \_\_\_\_\_ (yield gpm)  
 (type power) \_\_\_\_\_
- (7) electric log no (yes or no)  
 (organization running log) \_\_\_\_\_
- (8) how well bottom plugged B.P. Valve

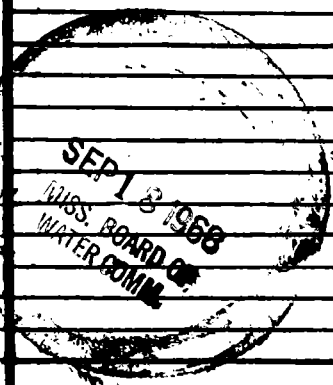

DRILLERS REMARKS: pump installed by owner

If well telescopes please sketch and show depths.

GROUND LEVEL

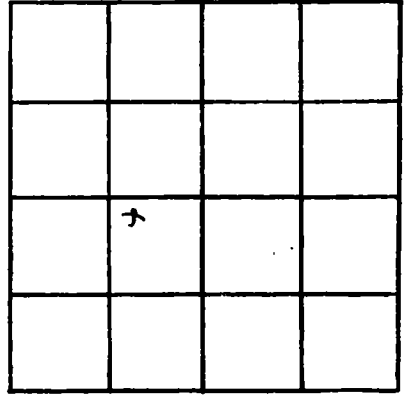

SECTION 34

Please indicate well location X.

ADDITIONAL INFORMATION

If more than one screen, show locations of each on sketch.