

Jackson
 0129
 11-27-65

MISSISSIPPI
 BOARD OF WATER COMMISSIONERS
 416 North State Street
 Jackson, Mississippi 39201

CODED

WATER WELL DRILLERS LOG

Nov 27 1965 Arville Water Sup Jackson
 date well completed firm name County well located

LANDOWNER: Dr. H. H. Robinson
Gautier
 (mailing address)


description of formations encountered	from	to
clay	0	88
sand	88	103

WELL LOCATION:
 sec. 19 T 8 N R 7 E
14 miles West of Lasc
 (distance) (direction) (nearest town)

WELL PURPOSE: camp
 (home, irrigation, municipal, industrial)


- WELL COMPLETION DATA:
- (1) diameter (inches) 1 1/4
 - (2) total depth (feet) 103
 - (3) static water level (feet) 15 below above top of ground.
 - (4) casing Galv
 (material) (depth)
 - _____ If telescope see back.
 (size)
 - (5) screen 15 98
 (length) (depth to top)
 - 1 1/4 Open mesh
 (size) (material)
 - (6) pump _____
 (HP) (yield gpm)
 - _____ (type power)
 - (7) electric log no
 (yes or no)
 - _____ (organization running log)
 - (8) how well bottom plugged BP Value

DRILLERS REMARKS: pump installed by other

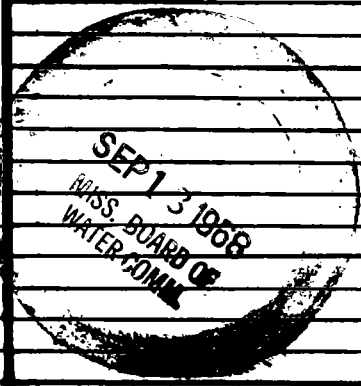

If well telescopes please sketch and show depths.

GROUND LEVEL

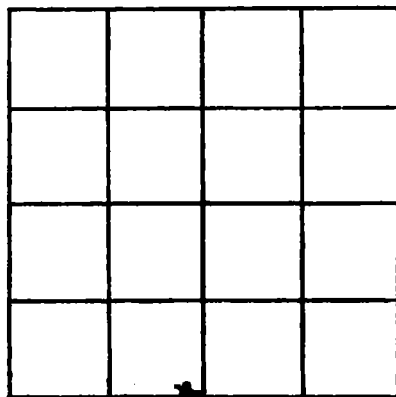

SECTION 19

Please indicate well location X.

ADDITIONAL INFORMATION

If more than one screen,
show locations of each on sketch.