

Jackson
 O 130
 3-10-66

MISSISSIPPI
 BOARD OF WATER COMMISSIONERS
 416 North State Street
 Jackson, Mississippi 39201

CODED

WATER WELL DRILLERS LOG

Mar 10 1966 Colville Water Supply Jackson
 date well completed firm name county well located

LANDOWNER: Cecil
McGhee
Bautier
 (mailing address)

description of formations encountered	depth	
	from	to
Clay	0	20
sand	20	80
Clay	80	154
sand	154	210
mud	210	242

WELL LOCATION:
 sec. 12 T. 7 N. R. 2 E.
6 miles NW of Pace
 (distance) (direction) (nearest town)

WELL PURPOSE: home
 (home, irrigation, municipal, industrial)

WELL COMPLETION DATA:

(1) diameter (inches) 2

(2) total depth (feet) 242

(3) static water level (feet) 15 ^{below} above top of ground.

(4) casing galv (material) (depth) _____
 (size) If telescope see back.


(5) screen 5 237 (length) (depth to top)
2 stainless (size) (material)

(6) pump _____ (HP) _____ (yield gpm)
 (type power) _____

(7) electric log no (yes or no)
 (organization running log) _____

(8) how well bottom plugged BPU


CODED

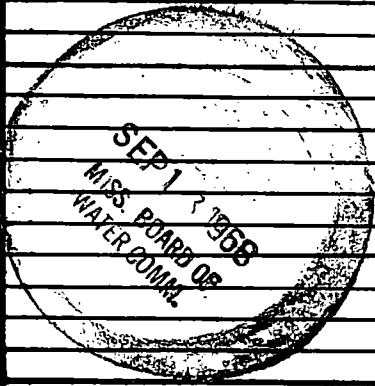

DRILLERS REMARKS: pump installed by others

If well telescopes please sketch and show depths.

GROUND LEVEL

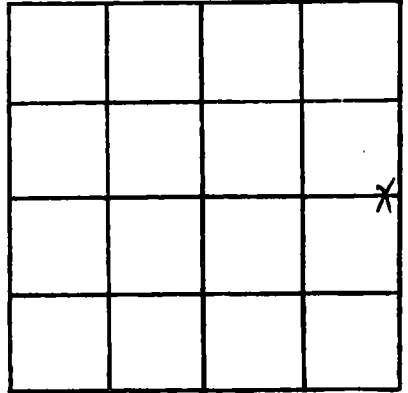

SECTION 12

Please indicate well location X.

ADDITIONAL INFORMATION

If more than one screen, show locations of each on sketch.