

Jackson  
 0132  
 6-23-66

MISSISSIPPI  
 BOARD OF WATER COMMISSIONERS ~~SEDED~~  
 416 North State Street  
 Jackson, Mississippi 39201

WATER WELL DRILLERS LOG

June 23 1966 Osborne Water Supply Jackson  
 date well completed firm name county well located


LANDOWNER: <u>Bay Point</u>	description of formations encountered	from	to
<u>Reality</u>			
<u>Laurel, Miss</u> (mailing address)	<u>clay</u> <u>sand</u>	<u>0</u> <u>60</u>	<u>60</u> <u>70</u>
WELL LOCATION:			
sec. <u>33</u> T. <u>7</u> N. R. <u>7</u> E. <u>9</u> miles <u>W</u> of <u>Pascagoula</u> (distance) (direction) (nearest town)			
WELL PURPOSE: <u>home</u> (home, irrigation, municipal, industrial)			
WELL COMPLETION DATA:			
(1) diameter (inches) <u>2</u>			
(2) total depth (feet) <u>70</u>			
(3) static water level (feet) <u>12</u> <sup>below</sup> above top of ground.			
(4) casing <u>galv</u> (material) (depth) _____ _____ (size) If telescope see back.			
(5) screen <u>5'</u> (length) <u>65'</u> (depth to top) <u>2"</u> (size) <u>Copper gauze</u> (material)			
(6) pump _____ (HP) _____ (yield gpm)			
(type power)			
(7) electric log <u>no</u> (yes or no)			
(organization running log)			
(8) how well bottom plugged <u>BP labor</u>			
DRILLERS REMARKS: <u>pump inst. by owner</u>			

APR 21 1966

MISS. BD. OF  
 WATER COMMISSIONERS

If well telescopes please sketch and show depths.

GROUND LEVEL

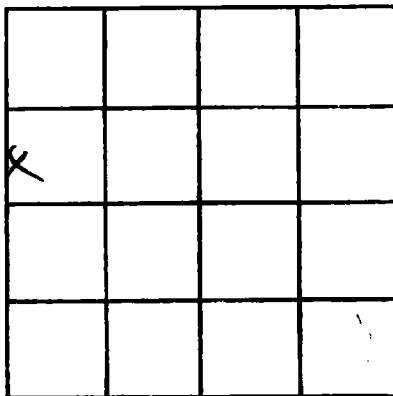

SECTION 33

Please indicate well location X.

ADDITIONAL INFORMATION

If more than one screen, show locations of each on sketch.