

Jackson  
 0133  
 8-29-66

MISSISSIPPI  
 BOARD OF WATER COMMISSIONERS  
 416 North State Street  
 Jackson, Mississippi 39201

CODED

WATER WELL DRILLERS LOG

Aug 29 1966 well completed  
 166 Lumbville Water Supply firm name  
 Jackson county well located

LANDOWNER: <u>Dr. R.A. Roberts</u>	description of formations encountered	from	to
<u>Fontainebleau, Miss</u> (mailing address)	<u>sand</u>	<u>0</u>	<u>70</u>
WELL LOCATION:			
sec. <u>19</u> T. <u>8</u> N. R. <u>7</u> E. <u>12</u> miles W of <u>Pascagoula</u> (distance) (direction) (nearest town)			
WELL PURPOSE: <u>camp</u>			
(home, irrigation, municipal, industrial)			
WELL COMPLETION DATA:			
(1) diameter (inches) <u>1 1/4</u>			
(2) total depth (feet) <u>70</u>			
(3) static water level (feet) <u>1.3</u> <sup>below</sup> above top of ground.			
(4) casing <u>galv</u> (material) (depth)			
(size) If telescope see back.			
(5) screen <u>5'</u> (length) <u>65'</u> (depth to top)			
<u>1/4</u> (size) <u>Copper gauze</u> (material)			
(6) pump (HP) (yield gpm)			
(type power)			
(7) electric log <u>no</u> (yes or no)			
(organization running log)			
(8) how well bottom plugged <u>B.P. Valve</u>			
DRILLERS REMARKS: <u>Pump installed by owner</u>			


CODED

APR 21 1968

MISS. BD. OF  
 WATER COMMISSIONERS

If well telescopes please sketch and show depths.

GROUND LEVEL

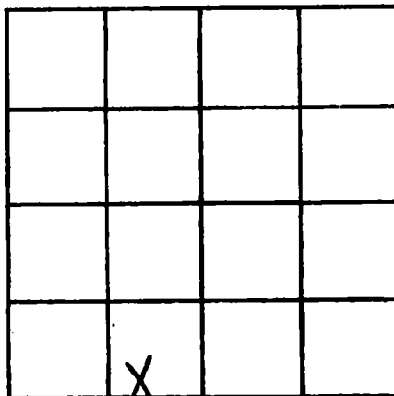

*Greg.*  
SECTION 19

Please indicate well location X.

ADDITIONAL INFORMATION

If more than one screen, show locations of each on sketch.