

Jackson
0134
8-30-66

MISSISSIPPI
 BOARD OF WATER COMMISSIONERS CODED
 416 North State Street
 Jackson, Mississippi 39201

WATER WELL DRILLERS LOG

Aug 30 19 66 Labette Water Supply Jackson
 d.w. well completed firm name county well located

LANDOWNER:	description of formations encountered	from	to
<u>Henry Anderson</u>			
<u>Laudier Min</u> (mailing address)	<u>sand</u>	<u>0</u>	<u>22</u>
	<u>Clay</u>	<u>22</u>	<u>66</u>
	<u>sand</u>	<u>66</u>	<u>85</u>

WELL LOCATION:

sec. 36 T 3 N R. 7 E
6 miles W of Pascagoula
 (distance) (direction) (nearest town)

WELL PURPOSE: Home
 (home, irrigation, municipal, industrial)

WELL COMPLETION DATA:

(1) diameter (inches) 1 1/4

(2) total depth (feet) 85

(3) static water level (feet) 19 below above top of ground.

(4) casing Galv (material), _____ (depth)
 _____ (size) if telescope see back.

(5) screen 5' (length), 80 (depth to top)
1 1/4 (size), Copper gauze (material)

(6) pump _____ (HP) _____ (yield gpm)
 _____ (type power)

(7) electric log no (yes or no)
 _____ (organization running log)

(8) how well bottom plugged SP/dry

CODED


APR 21 1968

MISS. BD. OF WATER COMMISSIONERS

DRILLERS REMARKS: pump installed by owner

If well telescopes please sketch and show depths.

GROUND LEVEL

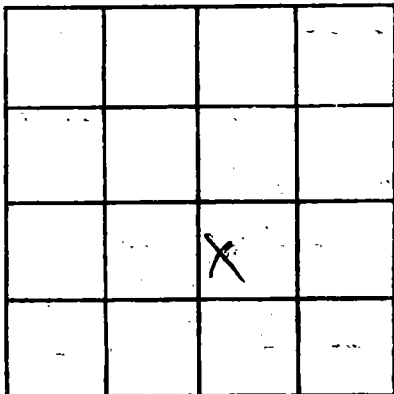

SECTION 36

Please indicate well location X.

ADDITIONAL INFORMATION

A series of 20 horizontal lines provided for writing additional information.

If more than one screen, show locations of each on sketch.