

Jackson
0141
10-2-69

MISSISSIPPI
BOARD OF WATER COMMISSIONERS
416 North State Street
Jackson, Mississippi 39201

CODED

WATER WELL DRILLERS LOG

10-2 19 69 Coast Water Well Service Jackson
date well completed firm name county well located

LANDOWNER: W. J. Roberts
Laurel, Miss.
(mailing address)

WELL LOCATION:
sec. 14 T 8 N R 7 E
S W
6 miles W of Osceola
(distance) (direction) (nearest town)

WELL PURPOSE: Home
(home, irrigation, municipal, industrial)

WELL COMPLETION DATA:

- (1) diameter (inches) 2
- (2) total depth (feet) 798
- (3) static water level (feet) 8 below top of ground.
- (4) casing galv., 778'
(material) (depth)
2" If telescope see back.
(size)
- (5) screen 20', 778'
(length) (depth to top)
2", Stainless Borlug
(size) (material)
- (6) pump 1 16
(HP) (yield gpm)
elec.
(type power)
- (7) electric log N/O
(yes or no)
- (organization running log)
- (8) how well bottom plugged Back-
wash collar


description of formations encountered	from	to
Surface Soil	0	17
Sand	17	29
Blue clay	29	44
Sand med. to coarse	44	98
Blue clay	98	157
Sand med. to coarse	157	327
Blue clay thin streaks sand	327	700
Sand med. to coarse	700	798

OCT 24 1969
MISS. BD OF WATER COMM.

DRILLERS REMARKS:

If well telescopes please sketch and show depths.

GROUND LEVEL

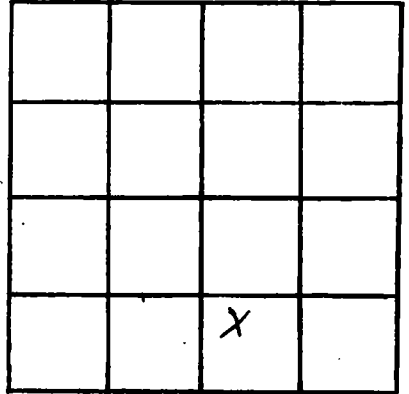

SECTION 14

Please indicate well location X.

ADDITIONAL INFORMATION

If more than one screen, show locations of each on sketch.