

CODED

Jackson
O 143
10-20-69

MISSISSIPPI
BOARD OF WATER COMMISSIONERS
416 North State Street
Jackson, Mississippi 39201

WATER WELL DRILLERS LOG


10-20 1969 Carot Water Well Serv. Inc. Jackson
date well completed firm name county well located

LANDOWNER: <u>John Grant</u>	description of formations encountered	from	to
<u>Star Route</u>			
<u>Star Route</u>	<u>Surface soil + sandy clay</u>	<u>0</u>	<u>15</u>
<u>Star Route</u>	<u>Blue clay</u>	<u>15</u>	<u>63</u>
<u>Star Route, Miss.</u>	<u>Sand - med to coarse</u>	<u>63</u>	<u>126</u>
(mailing address)	<u>Blue clay + sandy shale</u>	<u>126</u>	<u>210</u>
WELL LOCATION:	<u>Sand - med. to coarse</u>	<u>210</u>	<u>327</u>
sec <u>34</u> T <u>7</u> S R <u>7</u> W	<u>Blue Clay</u>	<u>327</u>	<u>480</u>
<u>7</u> miles <u>west</u> of <u>Pharagould</u>	<u>Sand - med. to coarse</u>	<u>480</u>	<u>557</u>
(distance) (direction) (nearest town)			
WELL PURPOSE: <u>Home</u>			
(home, irrigation, municipal, industrial)			
WELL COMPLETION DATA:			
(1) diameter (inches) <u>2</u>			
(2) total depth (feet) <u>257</u>			
(3) static water level (feet) <u>10</u> below above top of ground.			
(4) casing <u>galv.</u> , <u>247'</u>			
(material) (depth)			
<u>2"</u> if telescope see back.			
(size)			
(5) screen <u>10'</u> , <u>247'</u>			
(length) (depth to top)			
<u>2"</u> , <u>Stanley Barlog</u>			
(size) (material)			
(6) pump <u>1</u> , <u>15</u>			
(HP) (yield gpm)			
<u>Elec.</u>			
(type power)			
(7) electric log <u>NO</u>			
(yes or no)			
<u></u>			
(organization running log)			
(8) how well bottom plugged <u>Back-</u>			
<u>Work Value</u>			
DRILLERS REMARKS:			

10-20-1969
MISS. BD. OF WATER

If well telescopes please sketch and show depths.

GROUND LEVEL

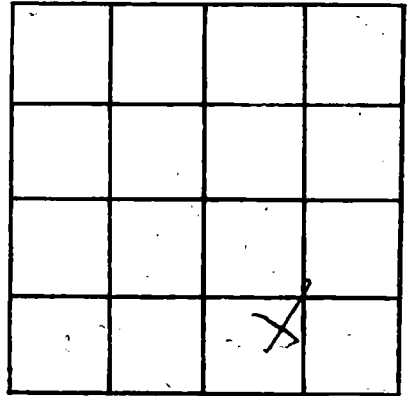

SECTION 34

Please indicate well location X.

ADDITIONAL INFORMATION

If more than one screen,
show locations of each on sketch.