

Jackson
 0147
 1-7-69

MISSISSIPPI
 BOARD OF WATER COMMISSIONERS
 416 North State Street
 Jackson, Mississippi 39201

CODED

WATER WELL DRILLERS LOG

Jan 9 1969 date well completed
 Cahille Water Supply firm name
 Jackson county well located

LANDOWNER: Floyd O. Gartman

description of formations encountered

from to

Mountain View Beach
 (mailing address)

sand	0	75
Clay	75	82
Clay and sand streak	82	132
sand	132	170
clay	170	176
sand	176	180
Clay	180	374
sand	374	390

WELL LOCATION:

sec. 19 T. 8 N. R. 7 E.
 7 miles West of Pass
 (distance) (direction) (nearest town)

WELL PURPOSE: Camp
 (home, irrigation, municipal, industrial)

WELL COMPLETION DATA:

- diameter (inches) 2
- total depth (feet) 390
- static water level (feet) 13-9 (below) above top of ground.
- casing galv. (material), (depth)
 (size) If telescope see back.
- screen 5' (length), 385 (depth to top)
 2 (size), stainless (material)
- pump 1/2 (HP), 5 (yield gpm)
 elec (type power)
- electric log no (yes or no)

(organization running log)

(8) how well bottom plugged B.P. Valve


JAN - 8 1970

DRILLERS REMARKS:

MISS. BD. OF
 WATER COM.

If well telescopes please sketch and show depths.

GROUND LEVEL

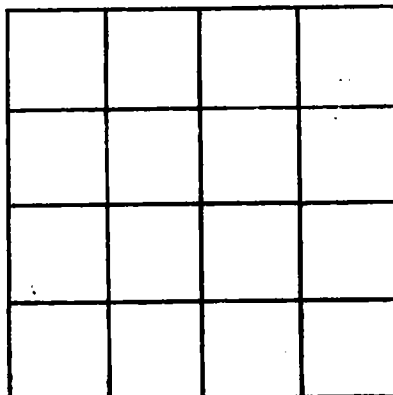

irregular section
SECTION 19

Please indicate well location X.

ADDITIONAL INFORMATION

If more than one screen,
show locations of each on sketch.