

Jackson
 149
 3-11-70

MISSISSIPPI
 BOARD OF WATER COMMISSIONERS
 416 North State Street
 Jackson, Mississippi 39201

WATER WELL DRILLERS LOG

3-11-70 date well completed Coast Water Well Serv firm name Ocean Springs location

LANDOWNER: Mary Engstrom
Rt. 3 Box 276
Ocean Springs Miss
 (mailing address)

description of formation encountered	depth	
	from	to
top soil + mud - coarse sand	0	157
blue clay	157	283
sand - fine & med.	283	325

WELL LOCATION:
 sec. 19 T. 8 N. R. 7 W.
8 miles SE of Ocean Springs
 (distance) (direction) (nearest town)

WELL PURPOSE: Home
 (home, irrigation, municipal, industrial)

- WELL COMPLETION DATA:
- (1) diameter (inches) 2
 - (2) total depth (feet) 325
 - (3) static water level (feet) 19 below top of ground.
 - (4) casing galv, 315'
 (material) (depth)
2" if telescope see back.
 (size)
 - (5) screen 10', 315'
 (length) (depth to top)
2", Stainless Borluq
 (size) (material)
 - (6) pump 1/2 10
 (HP) (yield gpm)
Elco
 (type power)
 - (7) electric log NO
 (yes or no)

(organization running log)
 (8) how well bottom plugged Back -
When Done

DRILLERS REMARKS:

COPIED


COPIED

MAR 17 1970

MISS. BD. OF
 WATER COMM

If well telescopes please sketch and show depths.

GROUND LEVEL

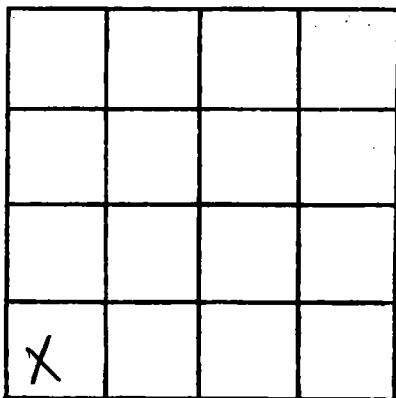

SECTION 19

Please indicate well location X.

ADDITIONAL INFORMATION

If more than one screen,
show locations of each on sketch.