

Jackson
 152
 3-26-70

MISSISSIPPI
 BOARD OF WATER COMMISSIONERS
 416 North State Street
 Jackson, Mississippi 39201

CODED

WATER WELL DRILLERS LOG

March 26 1970 Colville Water Supply Jackson
 (date well completed) (firm name) (county well located)

LANDOWNER: <u>Eddie Klayet and Frank Spann</u>	description of formations encountered	from	to
<u>Bel Fountain Beach</u> (mailing address)	<u>sand with small clayette</u> <u>clay</u> <u>sand</u>	<u>0</u> <u>221</u> <u>360</u>	<u>221</u> <u>360</u> <u>388</u>
<p>WELL LOCATION: sec. <u>17</u> T. <u>8</u> N. R. <u>7</u> E. <u>10</u> miles <u>SW</u> of <u>Paul</u> (distance) (direction) (nearest town)</p> <p>WELL PURPOSE: <u>Camp</u> (home, irrigation, municipal, industrial)</p> <p>WELL COMPLETION DATA:</p> <p>(1) diameter (inches) <u>2</u></p> <p>(2) total depth (feet) <u>388</u></p> <p>(3) static water level (feet) <u>9 1/4</u> <u>below</u> above top of ground.</p> <p>(4) casing <u>galv</u> (material) (depth)</p> <p>(size) If telescope see back.</p> <p>(5) screen <u>5</u> <u>383</u> (length) (depth to top)</p> <p><u>2</u> <u>stainless</u> (size) (material)</p> <p>(6) pump <u>2 1/2 Pump</u> <u>10</u> (HP) (yield gpm)</p> <p><u>elec</u> (type power)</p> <p>(7) electric log <u>no</u> (yes or no)</p> <p>(organization running log)</p> <p>(8) how well bottom plugged <u>BP Vahy</u></p>			
<p>DRILLERS REMARKS:</p>			


CODED

APR - 2 1970

MISS. BD. OF
 WATER COMM.

If well telescopes please sketch and show depths.

GROUND LEVEL

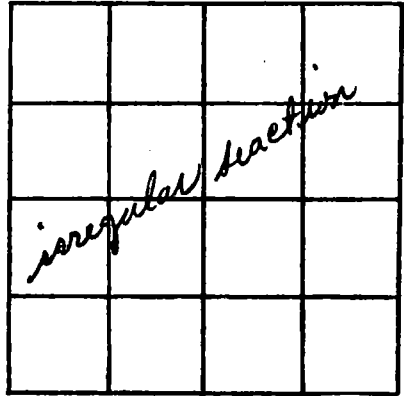

SECTION 17

Please indicate well location X.

ADDITIONAL INFORMATION

If more than one screen, show locations of each on sketch.