

Jackson
 153
 4-22-70

MISSISSIPPI
 BOARD OF WATER COMMISSIONERS
 416 North State Street
 Jackson, Mississippi 39201

CODED

WATER WELL DRILLERS LOG

4-22 1970
 date well completed

Coast Water Well Service
 firm name

Jackson
 county well located

LANDOWNER: Best City Marina

description of formations encountered

from

to

P.O. Box 1599

Sand fill

0

16

Pracagoula, Miss.
 (mailing address)

Marsh grass & Sand

Med. ls. coarse

16

280

Btm. clay

280

380

WELL LOCATION:

158

Sand fine to med.

380

430

sec. 27 T 7 N R 6 E

3 miles W of Pracagoula
 (distance) (direction) (nearest town)

WELL PURPOSE: Best Storage
 (home, irrigation, municipal, industrial)

WELL COMPLETION DATA:

(1) diameter (inches) 4"

(2) total depth (feet) 409'

(3) static water level (feet) 19 below above top of ground.

(4) casing galv. 389'
 (material) (depth)

4" if telescope see back.
 (size)

(5) screen 20' 489'
 (length) (depth to top)

4" All Stainless
 (size) (material)

(6) pump 5 Sub. 90
 (HP) (yield gpm)

elec.
 (type power)

(7) electric log NO
 (yes or no)

(organization running log)


(8) how well bottom plugged Back - Wash Valve

DRILLERS REMARKS: Dot Red Water at 430'. Pulled 21' back to a 409' setting.

MISSISSIPPI
 BOARD OF WATER COMMISSIONERS
 JUNE 12 1970

If well telescopes please sketch and show depths.

GROUND LEVEL

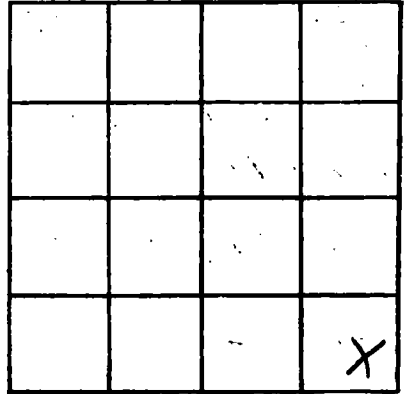

SECTION 27

Please indicate well location X.

ADDITIONAL INFORMATION

If more than one screen,
show locations of each on sketch.