

JACKSON  
 156  
 8-17-70

MISSISSIPPI  
 BOARD OF WATER COMMISSIONERS  
 416 North State Street  
 Jackson, Mississippi 39201

**CODED**

WATER WELL DRILLERS LOG

8-17 1970 SUTTER WELL WORKS Jackson  
 date well completed firm name county well located

LANDOWNER	Description of formations encountered	from	to
Seashore Utilities Box 1827-Battlefield Station Jackson, Miss. (mailing address)	Clay	0	10
	Sand, gravel with clay streaks	10	312
WELL LOCATION: sec 2 T 8 S R 7 W miles in Gautier (distance) (direction) (nearest town)	Clay	312	534
	Sand	534	552
	Clay	552	604
	Sand	604	618
WELL PURPOSE: SUB-DIVISION (home, irrigation, municipal, industrial)	Clay-sand streaks	618	700
	Sand	700	760
	Clay	760	768
WELL COMPLETION DATA: (1) diameter (inches) 6" x 10" (2) total depth (feet) 768' (3) static water level (feet) 15' below top of ground. (4) casing blk. steel 720' (material) (depth) 6 & 10" if telescope see back. (size) (5) screen 40' 720' (length) (depth to top) 6" stainless steel (size) (material) (6) pump 25 300 (HP) (yield gpm) elec. (type power) (7) electric log yes (yes or no) U.S.G.S. (organization running log) (8) how well bottom plugged B.P. Valve 8' blank pipe below strainer			
DRILLERS REMARKS: Copies made available to owner & Health Department at owner's request.			

**CODED**

AUG 21 1970

If well telescopes please sketch and show depths.


GROUND LEVEL

127' of 10" casing

12' of 6" overlap  
593' of 6" casing

6" x 40' screen

8' of 6" below screen

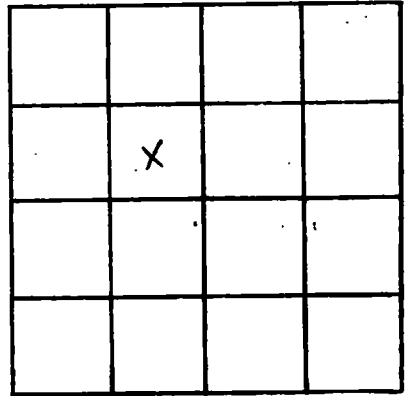

SECTION 2

Please indicate well location X.

ADDITIONAL INFORMATION

If more than one screen,  
show locations of each on sketch.