

JACKSON
 0158
 6-11-70

MISSISSIPPI
 BOARD OF WATER COMMISSIONERS
 416 North State Street
 Jackson, Mississippi 39201

CODED

WATER WELL DRILLERS LOG

6-11 date well completed 1970 Coast Water Well Service firm name Jackson county well located

LANDOWNER: R. E. Deakam
1424 - 14th St.
Jackson, Miss.
 (mailing address)

description of formations encountered	from	to
<u>Surface Soil</u>	<u>0</u>	<u>20</u>
<u>Fine Sand</u>	<u>20</u>	<u>36</u>
<u>Blue Clay</u>	<u>36</u>	<u>133</u>
<u>Sand Fine to med.</u>	<u>133</u>	<u>163</u>

WELL LOCATION:
 sec. 17 T-7N R-2W
6 miles E of Ocean Springs
 (distance) (direction) (nearest town)

WELL PURPOSE: Home
 (home, irrigation, municipal, industrial)

- WELL COMPLETION DATA:
- (1) diameter (inches) 2"
 - (2) total depth (feet) 163
 - (3) static water level (feet) 12 below top of ground.
 - (4) casing plastic (material) 153' (depth)
2" (size) If telescope see back.
 - (5) screen 10' (length) 153' (depth to top)
2" (size) plastic (material)
 - (6) pump 1/2 (HP) 10 (yield gpm)
elec. (type power)
 - (7) electric log no (yes or no)

CODED

(organization running log)

SEP 18 1970


(8) how well bottom plugged Backwash Valve

MISS. BD. OF
 WATER COMM.

DRILLERS REMARKS:

If well telescopes please sketch and show depths.

GROUND LEVEL

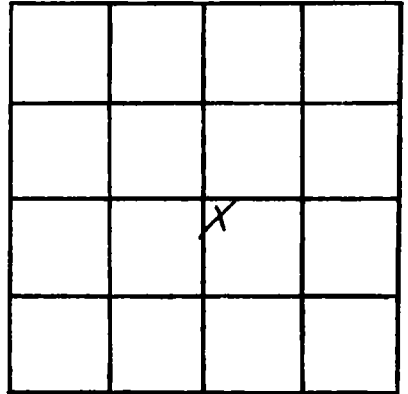

SECTION 17

Please indicate well location X.

ADDITIONAL INFORMATION

If more than one screen, show locations of each on sketch.