

JACKSON
#159
6-13-70

MISSISSIPPI
BOARD OF WATER COMMISSIONERS
416 North State Street
Jackson, Mississippi 39201

CODED

WATER WELL DRILLERS LOG

6-13-70 date well completed
1970 Carat Water Well Service firm name
Jackson county well located

LANDOWNER: Lloyd Hallbrook
Rt. 5 Rural Route
Ocean Springs, Miss.
Richmond St.
(mailing address)

description of formations encountered	from	to
	<u>Surface Soil</u>	<u>0</u>
<u>Fine Sand</u>	<u>18</u>	<u>42</u>
<u>Blue Clay + Sand Strakes</u>	<u>42</u>	<u>250</u>
<u>Sand Fine to med.</u>	<u>250</u>	<u>283</u>

WELL LOCATION:
sec. 17 T. 7 N. R. 7 E
S W
6 miles E of Ocean Springs
(distance) (direction) (nearest town)

WELL PURPOSE: Home
(home, irrigation, municipal, industrial)

WELL COMPLETION DATA:

- (1) diameter (inches) 2"
- (2) total depth (feet) 283'
- (3) static water level (feet) 19 below above top of ground.
- (4) casing plastic, 273'
(material) (depth)
2" if telescope see back.
(size)
- (5) screen 10', 273'
(length) (depth to top)
2", plastic
(size) (material)
- (6) pump 1, 10
(HP) (yield gpm)
Electric
(type power)
- (7) electric log NO
(yes or no)

(organization running log)
- (8) how well bottom plugged Backed with valve

CODED


SEP 18 1970

MISS. BD. OF
WATER COMM.

DRILLERS REMARKS:

If well telescopes please sketch and show depths.

GROUND LEVEL

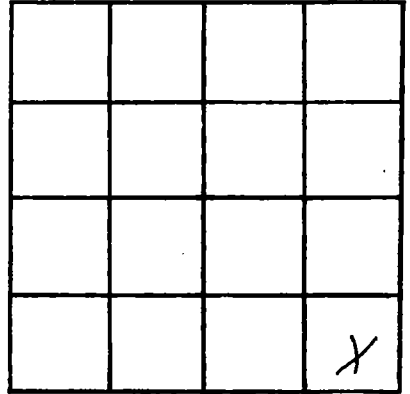

SECTION 17

Please indicate well location X.

ADDITIONAL INFORMATION

If more than one screen, show locations of each on sketch.