

Jackson
 163
 6-11-70

MISSISSIPPI
 BOARD OF WATER COMMISSIONERS
 416 North State Street
 Jackson, Mississippi 39201

CODED

WATER WELL DRILLERS LOG

June 11 1970 White Water Supply Jackson
 date well completed firm name county well located

LANDOWNER: J. E. Brondum
 Print-Clear Rivera
 (mailing address)

WELL LOCATION:
 sec 14 T 8 N R 7 E irregular section
 5 miles West of Hattiesburg
 (distance) (direction) (nearest town)

WELL PURPOSE: house
 (home, irrigation, municipal, industrial)

WELL COMPLETION DATA:
 (1) diameter (inches) 2
 (2) total depth (feet) 599
 (3) static water level (feet) 8 ^{below} _{above} top of ground.
 (4) casing galv 588
 (material) (depth)
 (size) if telescope see back.
 (5) screen 10 588
 (length) (depth to top)
2" stainless
 (size) (material)
 (6) pump 1 15
 (HP) (yield gpm)
elec
 (type power)
 (7) electric log no
 (yes or no)
 (organization running log)
 (8) how well bottom plugged BP Valve

| description of formations encountered | from | to |
|---------------------------------------|------|-----|
| pipe clay | 0 | 21 |
| soft blue clay | 21 | 40 |
| sand | 40 | 110 |
| clay | 115 | 142 |
| sand | 142 | 188 |
| clay | 188 | 212 |
| sand | 212 | 318 |
| clay | 318 | 440 |
| sand | 440 | 460 |
| clay | 460 | 520 |
| sand | 520 | 598 |

CODED


JUL 27 1970

DRILLERS REMARKS:

MISS. BD. OF
 WATER COMM.

If well telescopes please sketch and show depths.

GROUND LEVEL

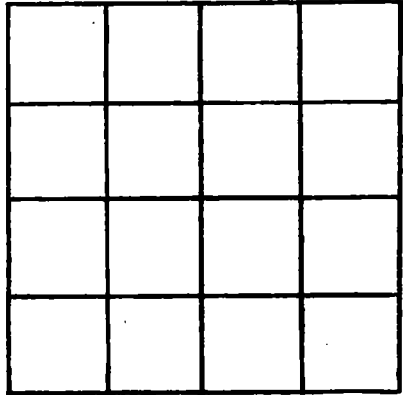

irregular section
SECTION _____

Please indicate well location X.

ADDITIONAL INFORMATION

Please send more envelopes.
Andrew Bohlen

If more than one screen, show locations of each on sketch.